


To Map

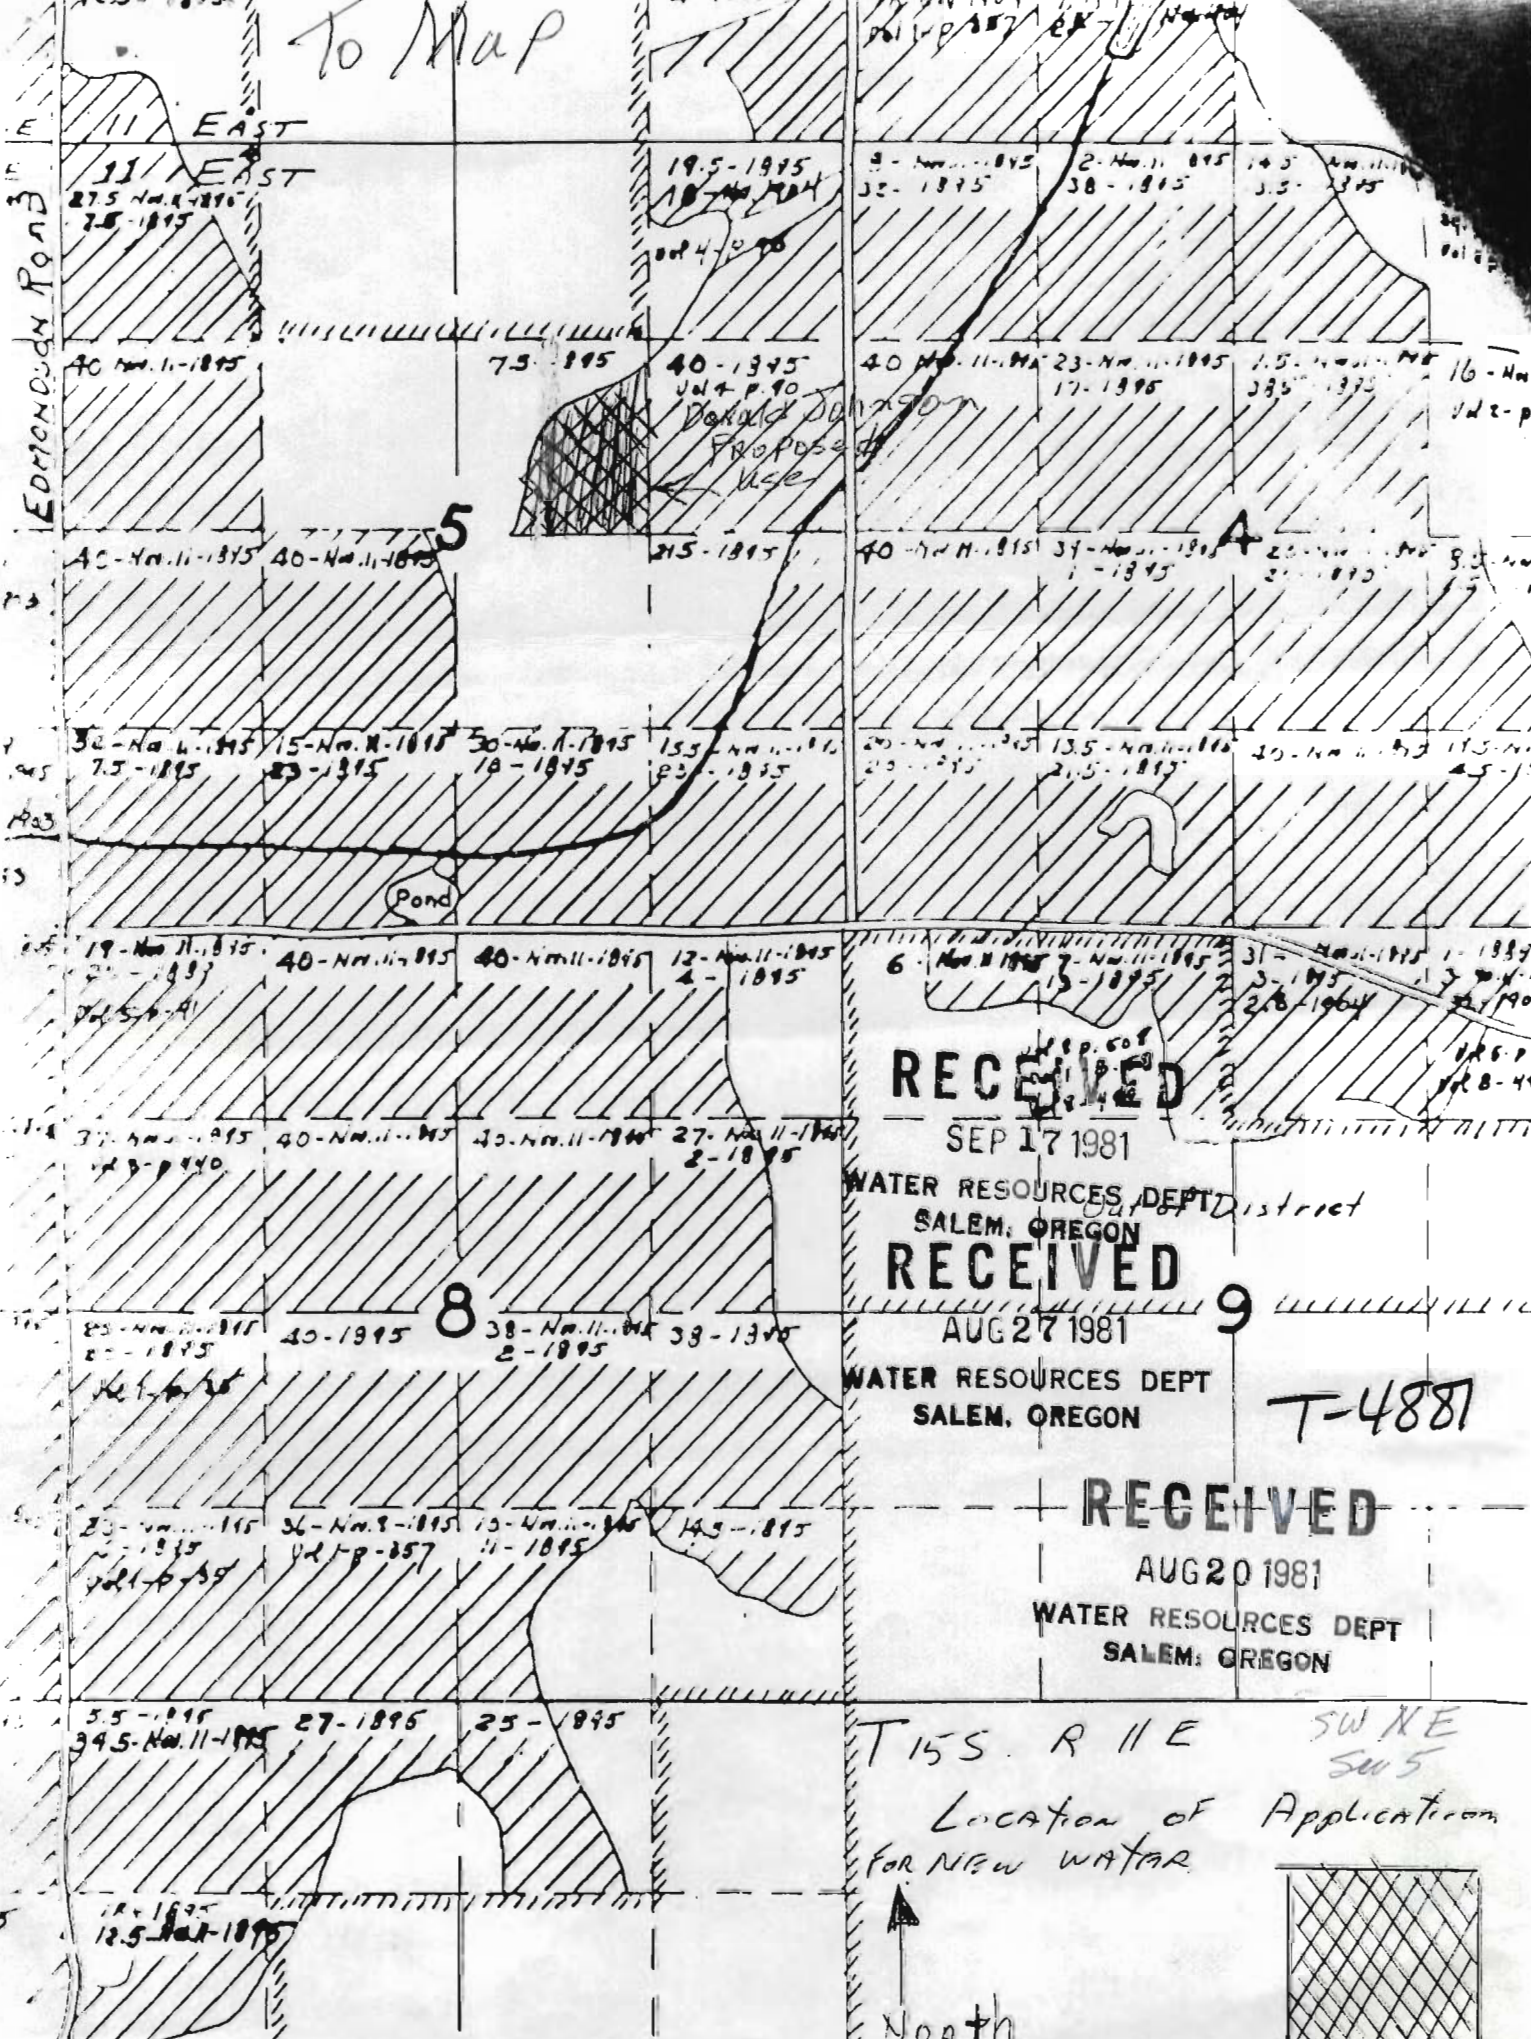

RECEIVED

SEP 17 1981

WATER RESOURCES DEPT
SALEM, OREGON

RECEIVED

AUG 27 1981

WATER RESOURCES DEPT
SALEM, OREGON


T-4881

RECEIVED

AUG 20 1981

WATER RESOURCES DEPT
SALEM, OREGON

T 15 S. R 11 E SW NE
SW 5
Location of Application
for NEW WATER

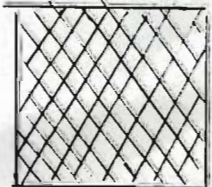

Mckenzie Canyon

Deschutes

Div. Pt. 0

From Map
Deep Canyon

14^s R12E Sec 17
16.0 acres in NW^{1/4} NE^{1/4}
From Robert K Beesley
to Donald Johnson


RECEIVED

AUG 27 1981

WATER RESOURCES DEPT
SALEM, OREGON

RECEIVED


SEP 17 1981

WATER RESOURCES DEPT
SALEM, OREGON

RECEIVED

AUG 20 1981

WATER RESOURCES DEPT
SALEM, OREGON

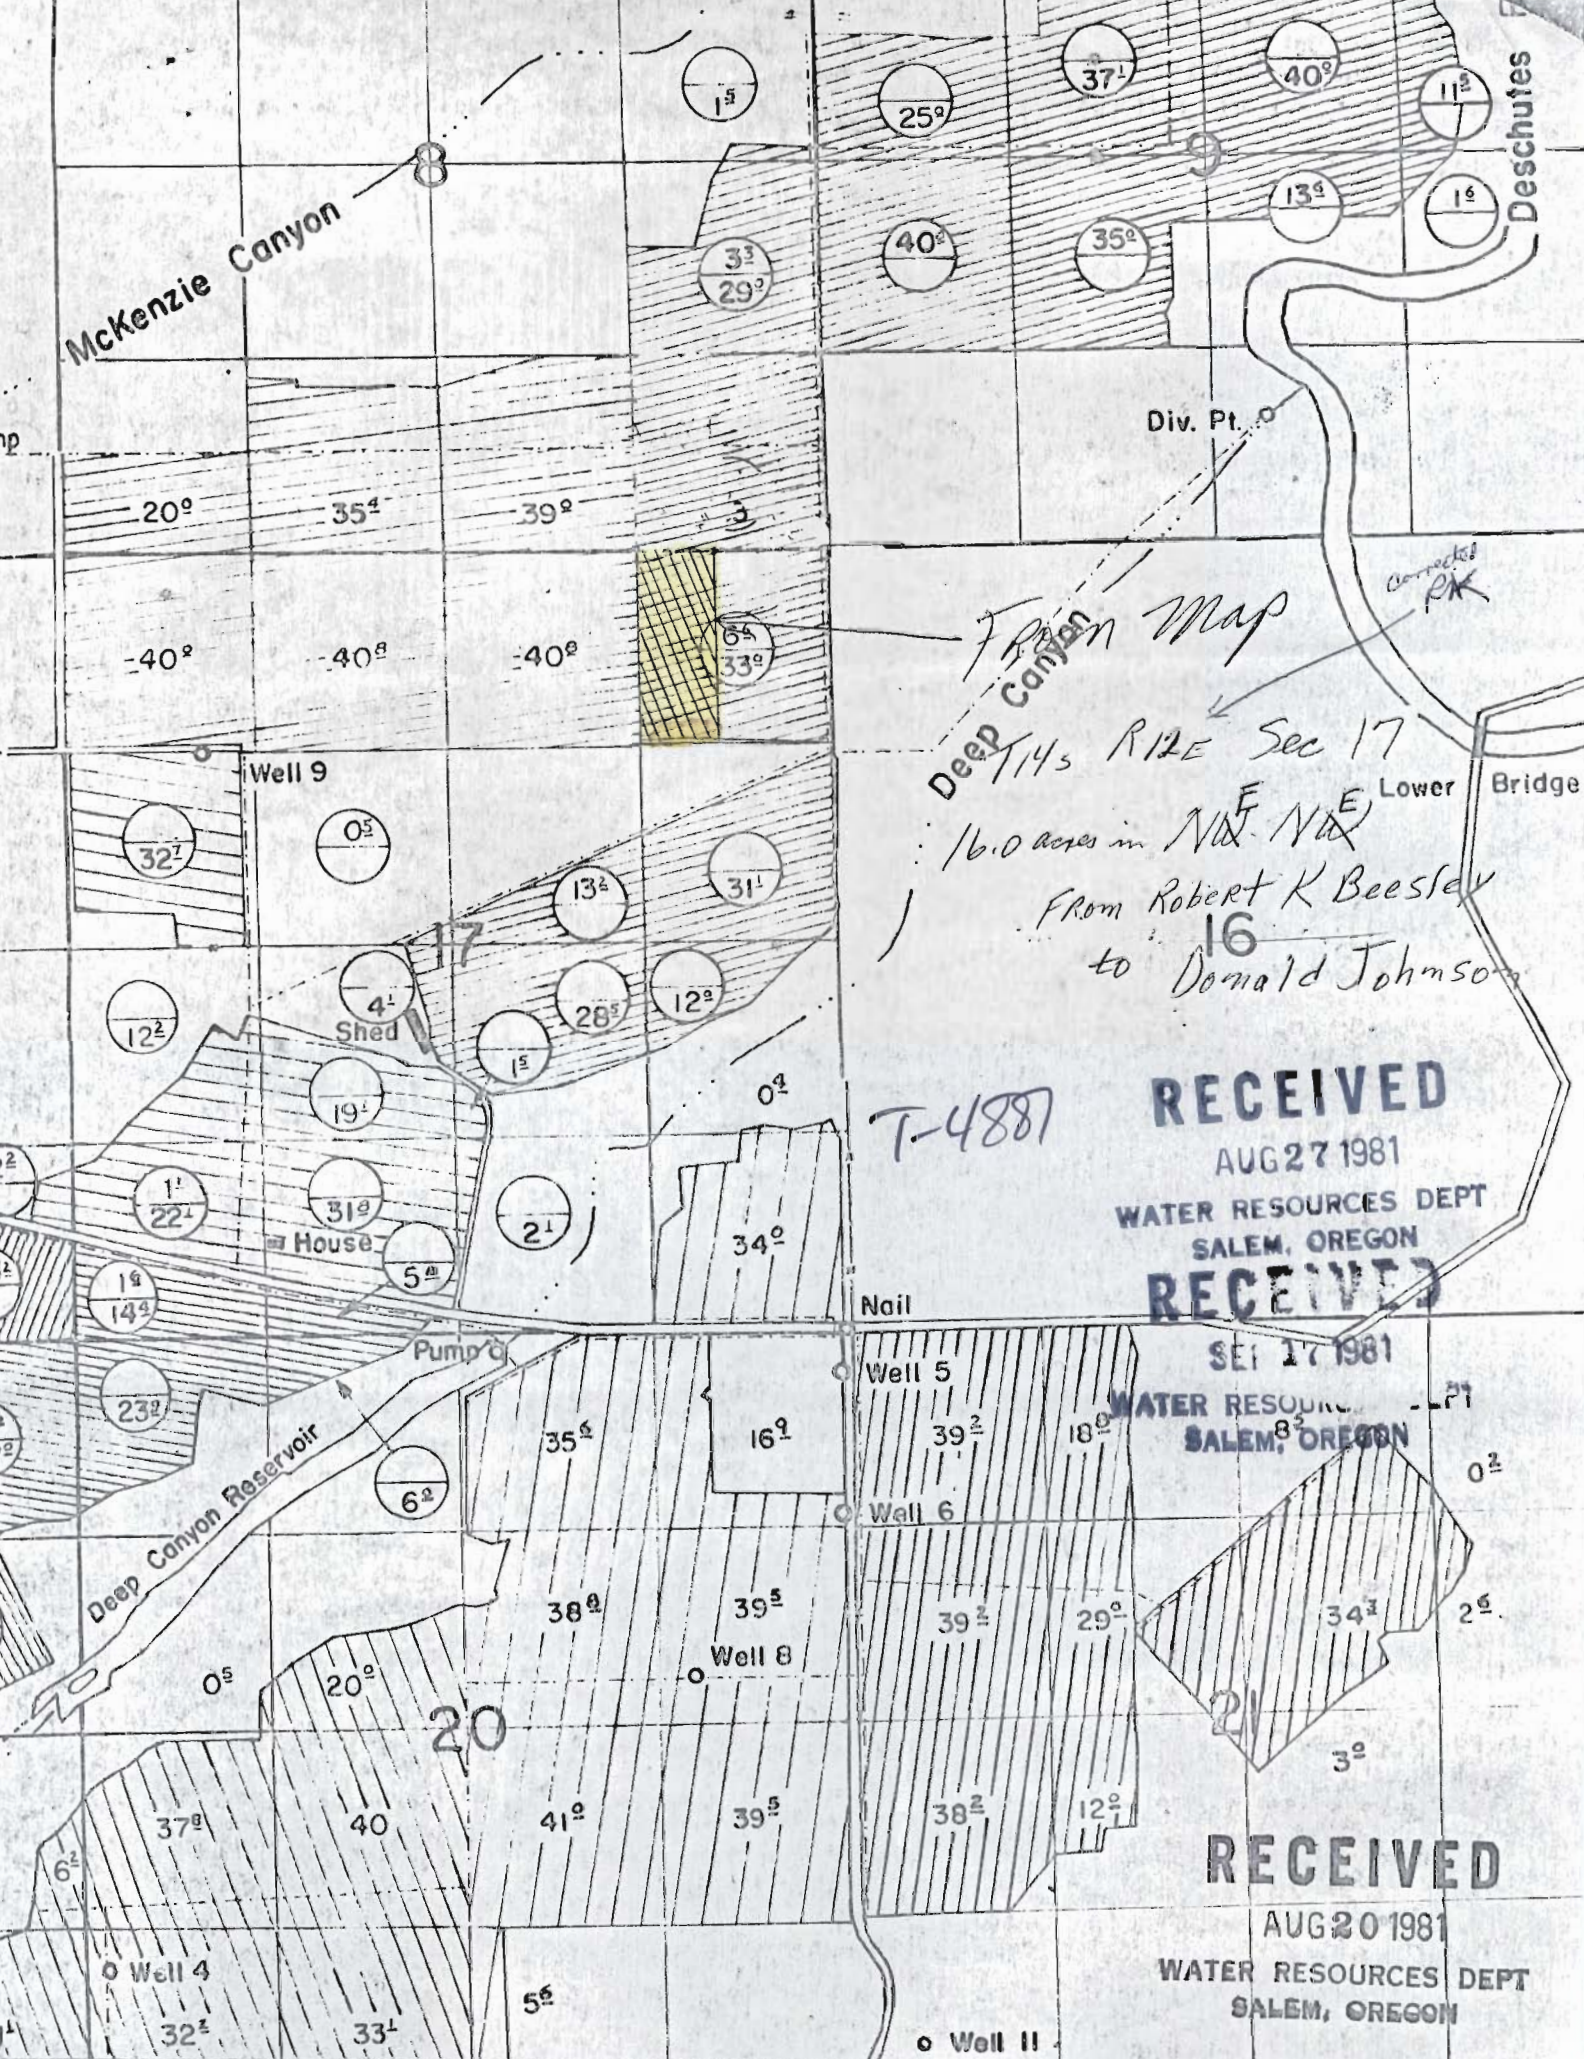

Well 9

Shed

House

Pump

Nail

Well 5

Well 6

Well 8

Well 4

Well 11

Lower Bridge

connected PK