


T-4900

RECEIVED

SEP 18 1981

WATER RESOURCES DEPT

SURVEYED SEPT 22-30, OCT 1,2,5,6,7, 1947 JULY 24, 2

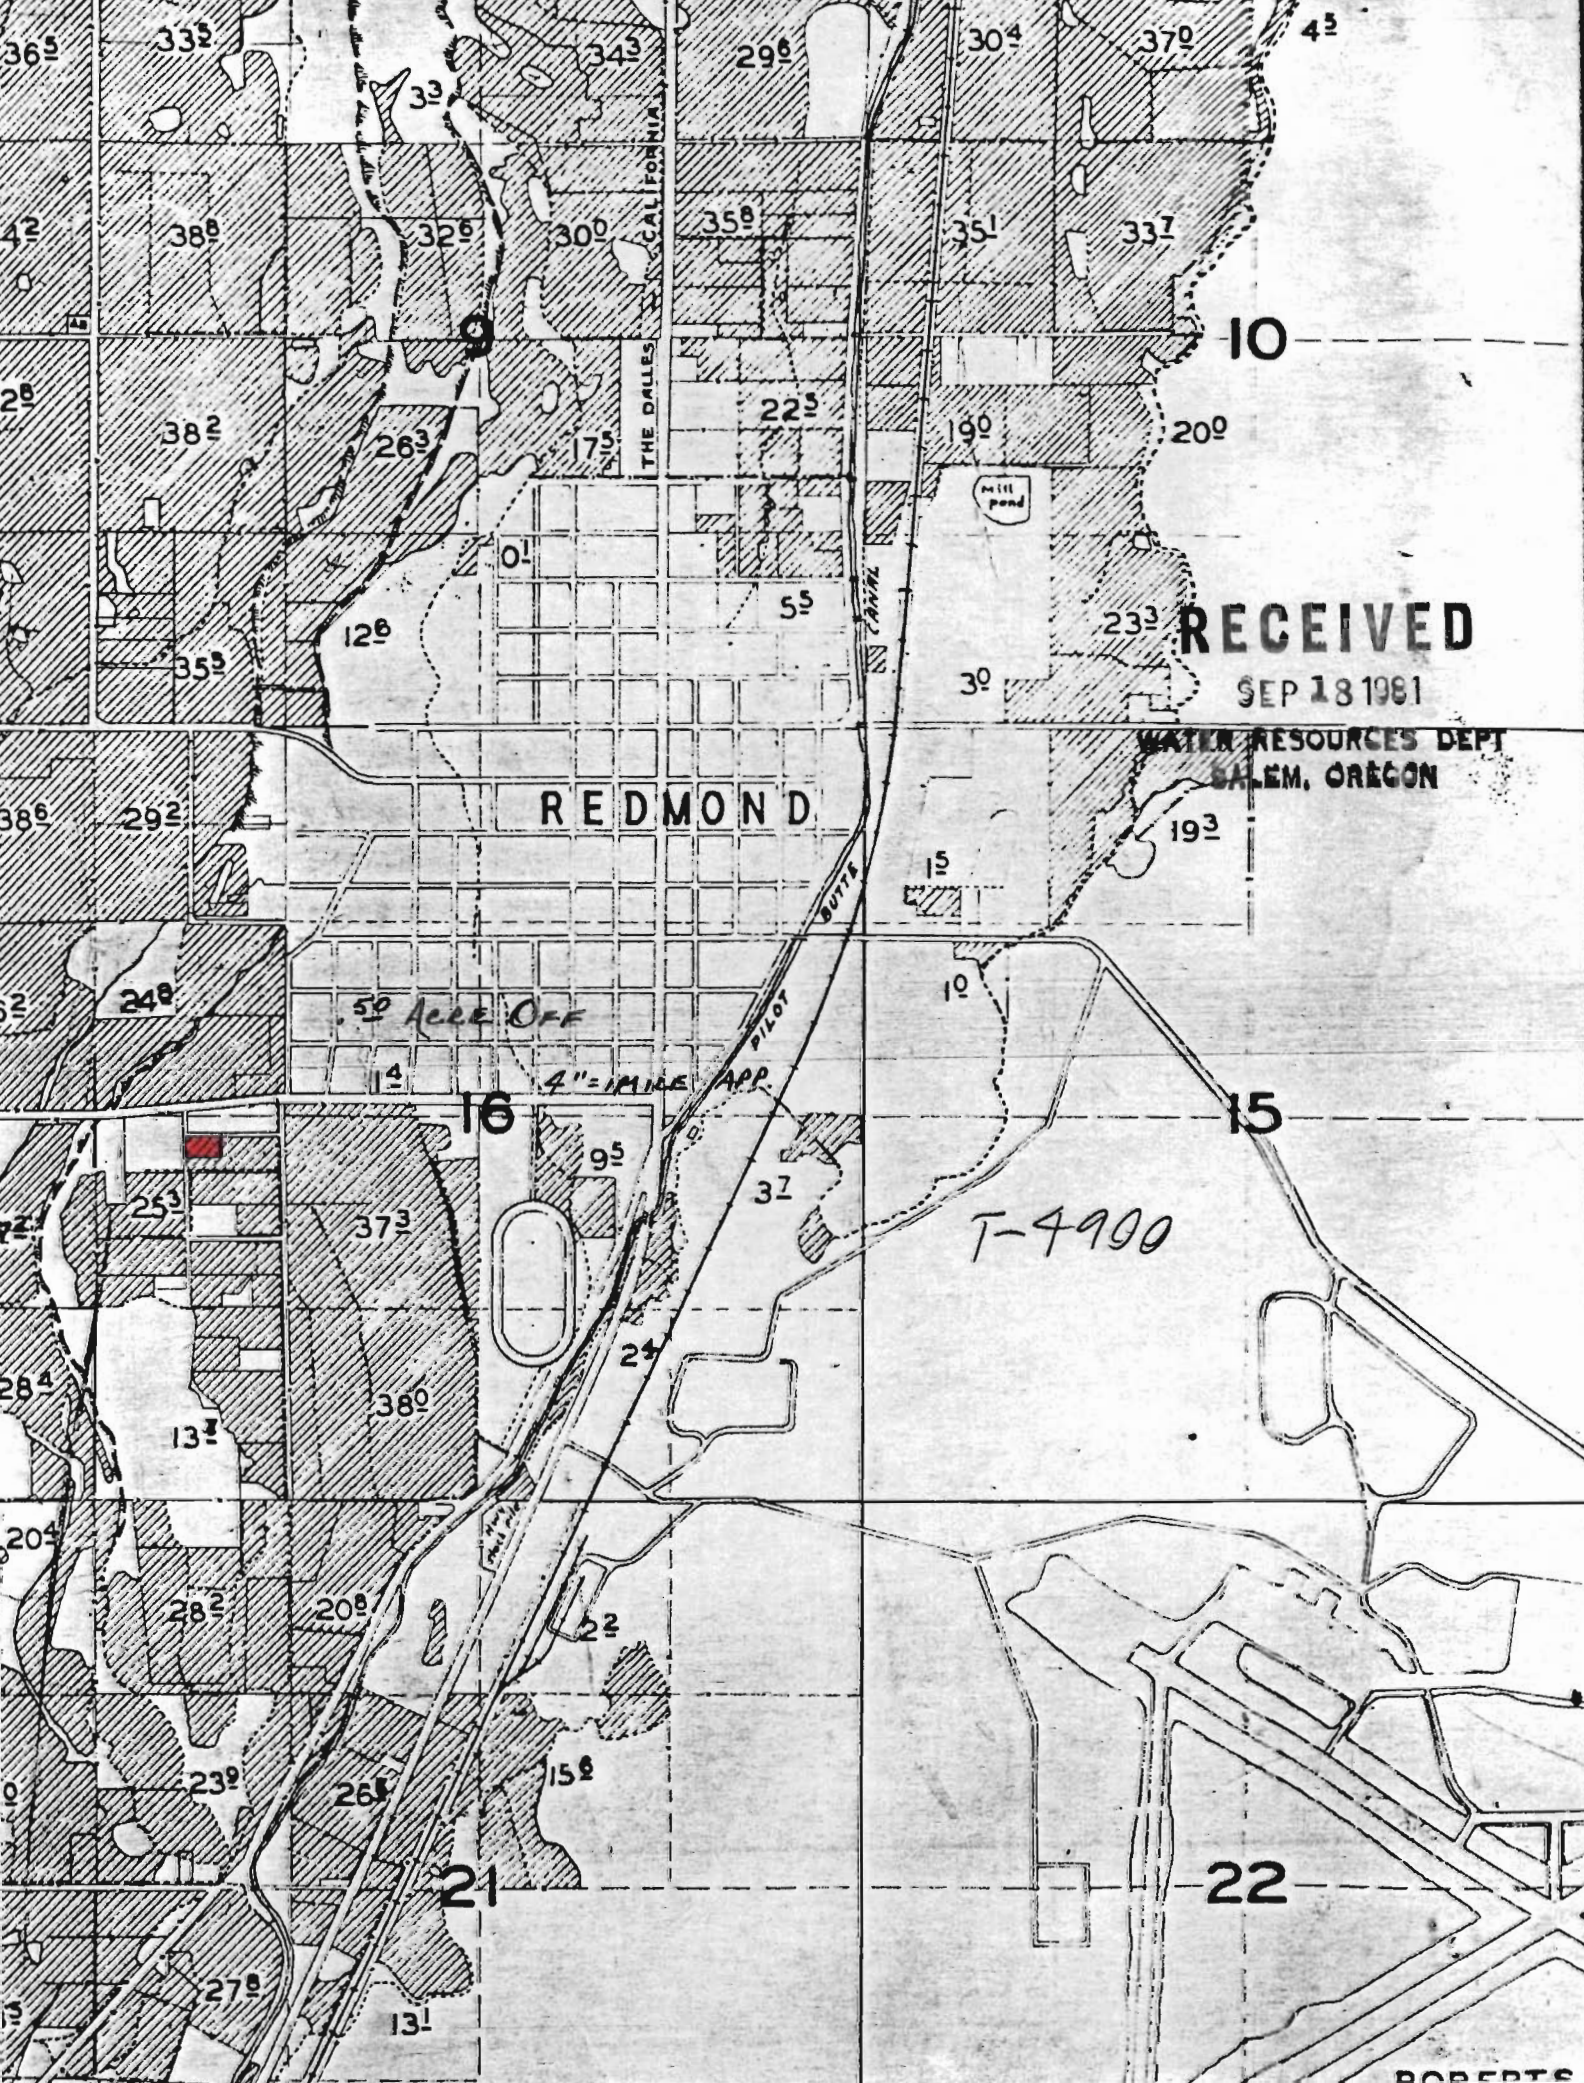

RECEIVED
SEP 18 1981

WATER RESOURCES DEPT
SALEM, OREGON

REDMOND

50 ACRES OFF

4" = 1 MILE APP.

T-4900

ROBERTS