

T-4903


RECEIVED


SEP 21 1981

WATER RESOURCES DEPT
SALEM, OREGON

37 Acre On

4" = 1 MILE APPROX

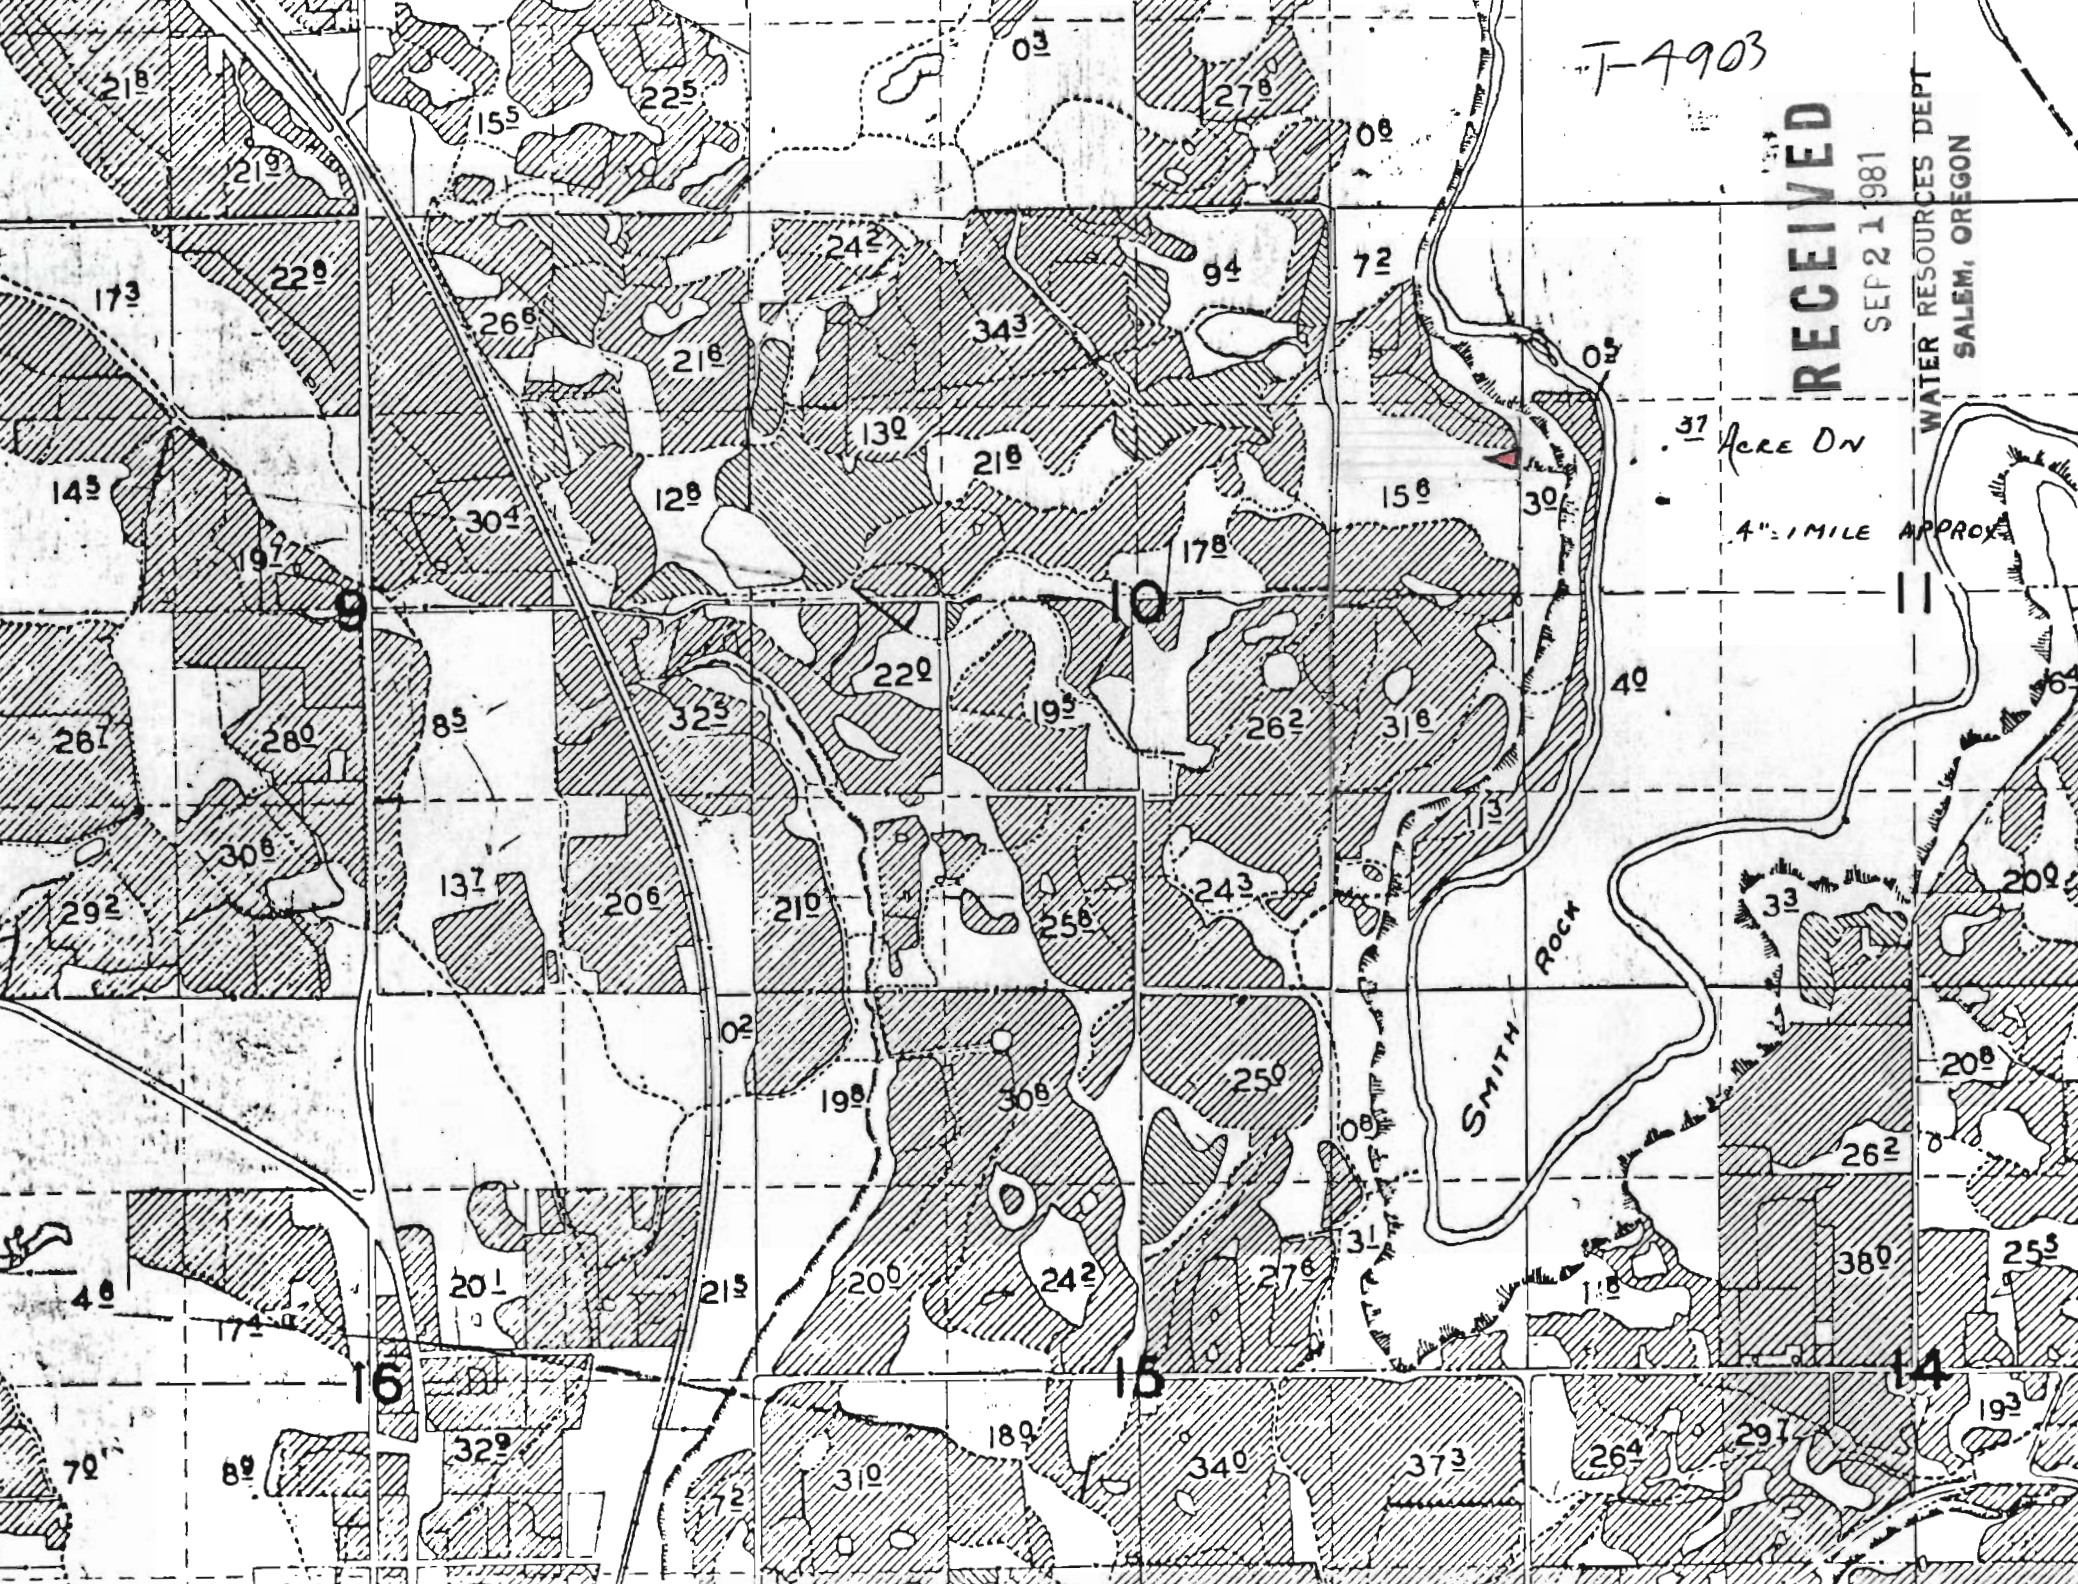

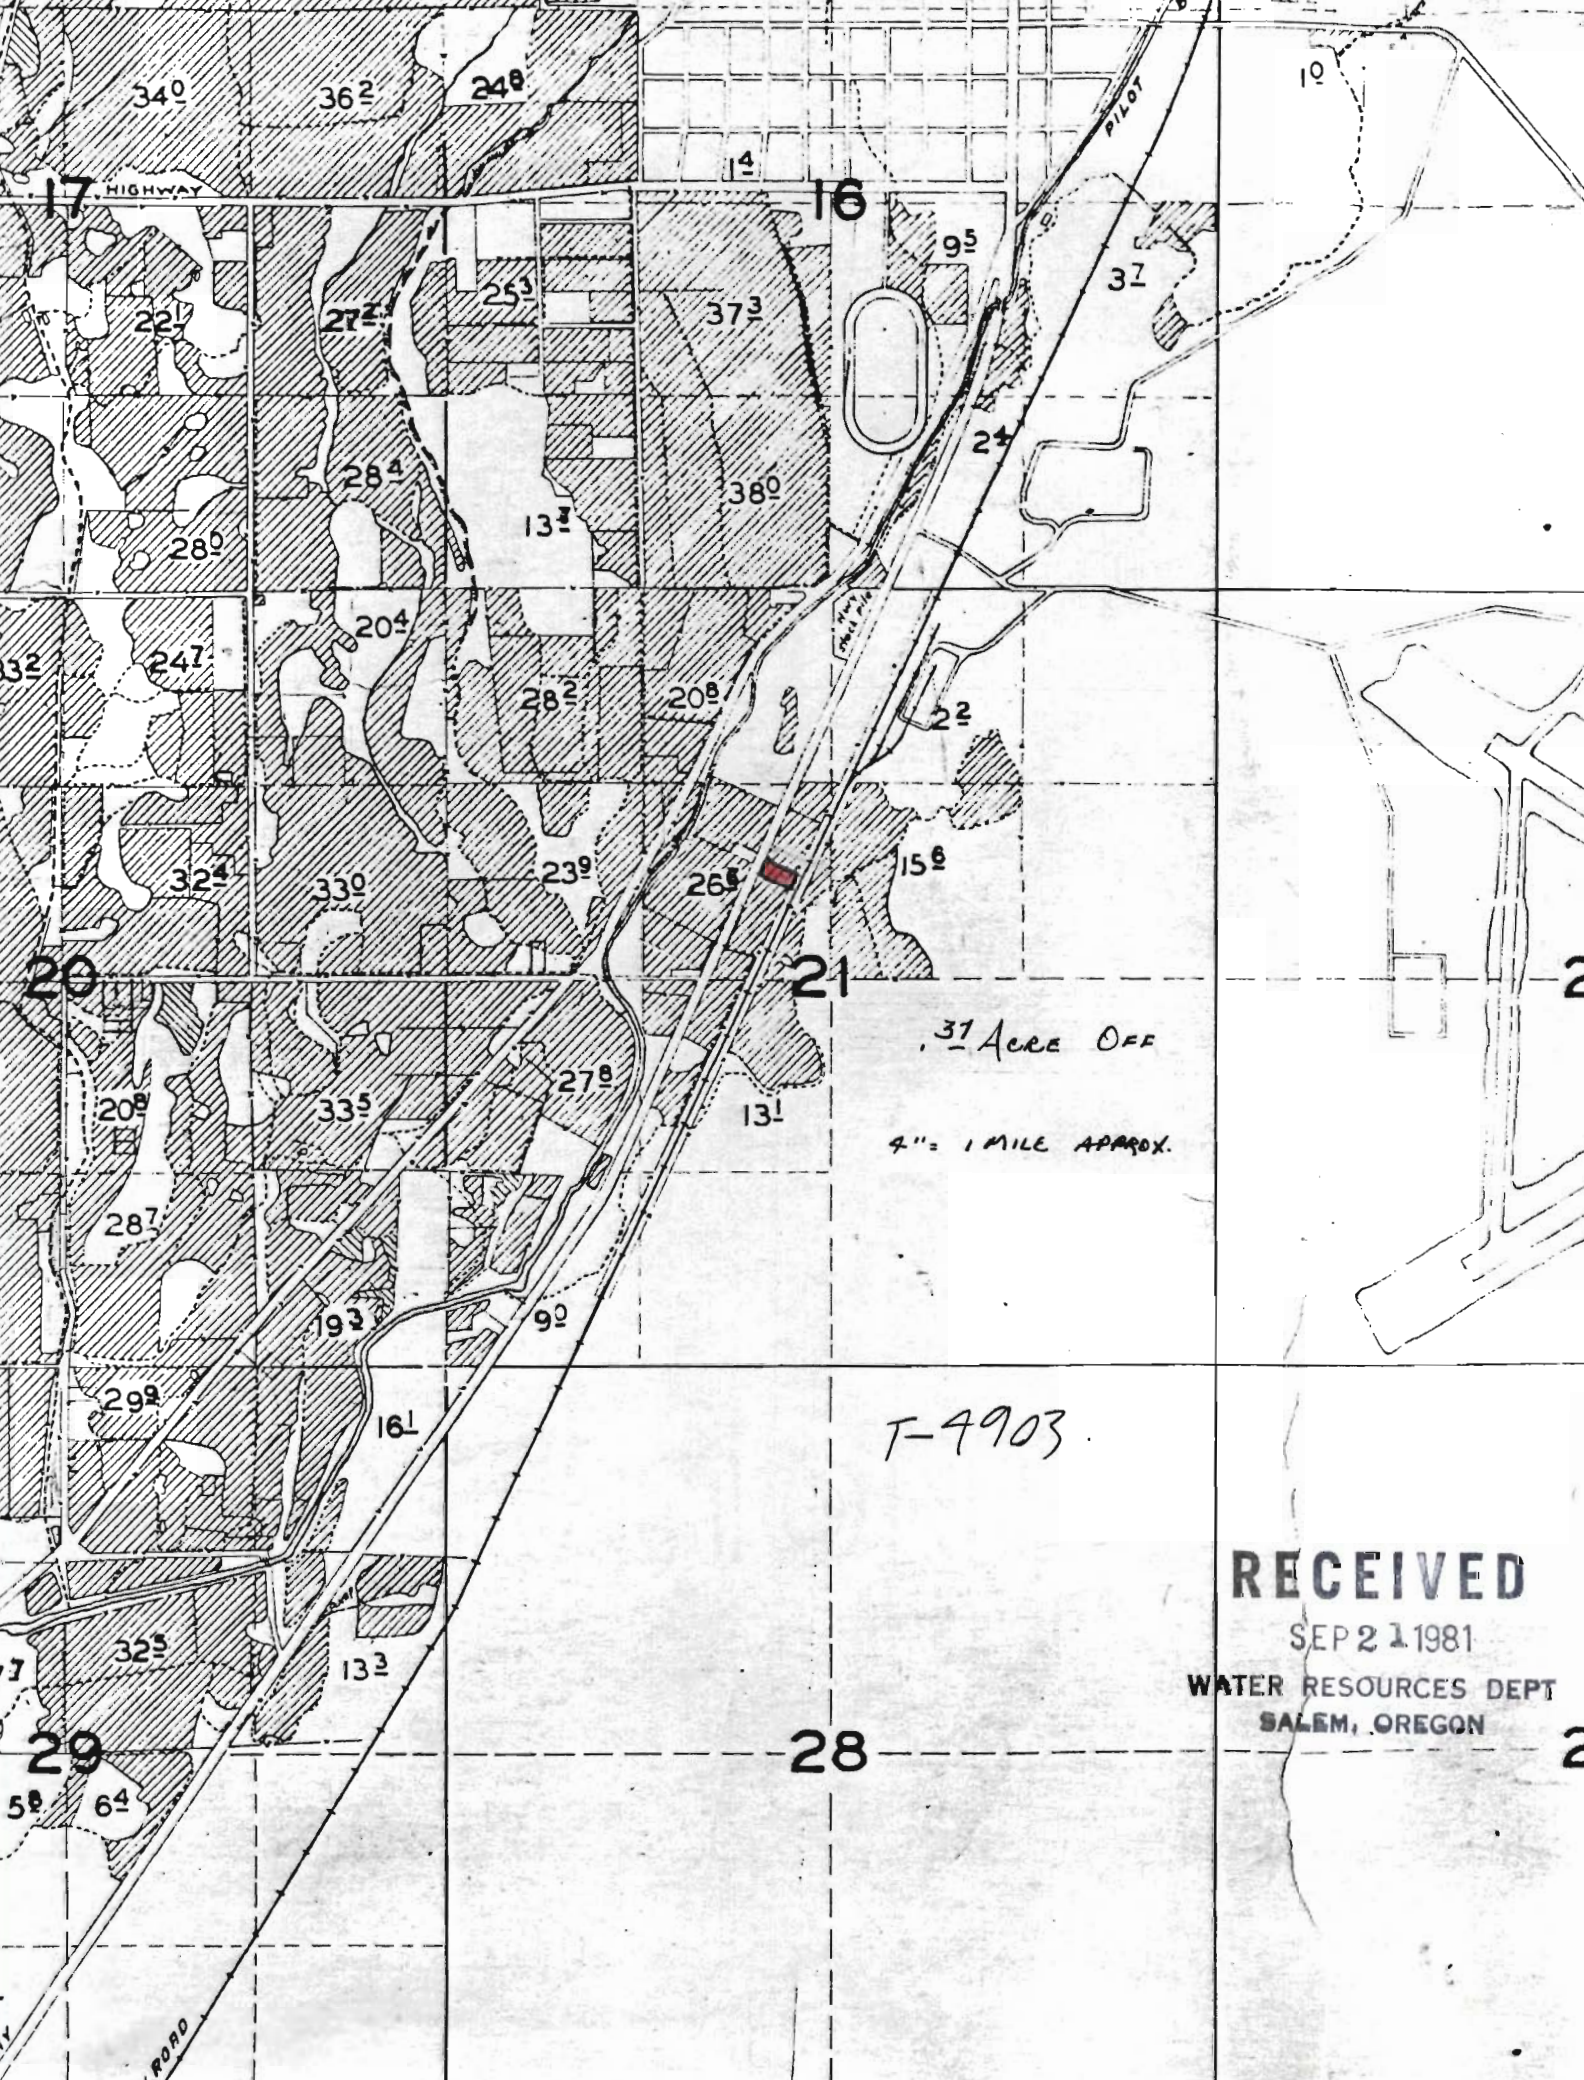

.37 ACRE OFF

4" = 1 MILE APPROX.


RECEIVED

SEP 21 1981


WATER RESOURCES DEPT
SALEM, OREGON

28

F-4903

SE 1/4 NE 1/4 SEC. 10 T. 14S. R. 13 E W M

SCALE: 1" = 200'

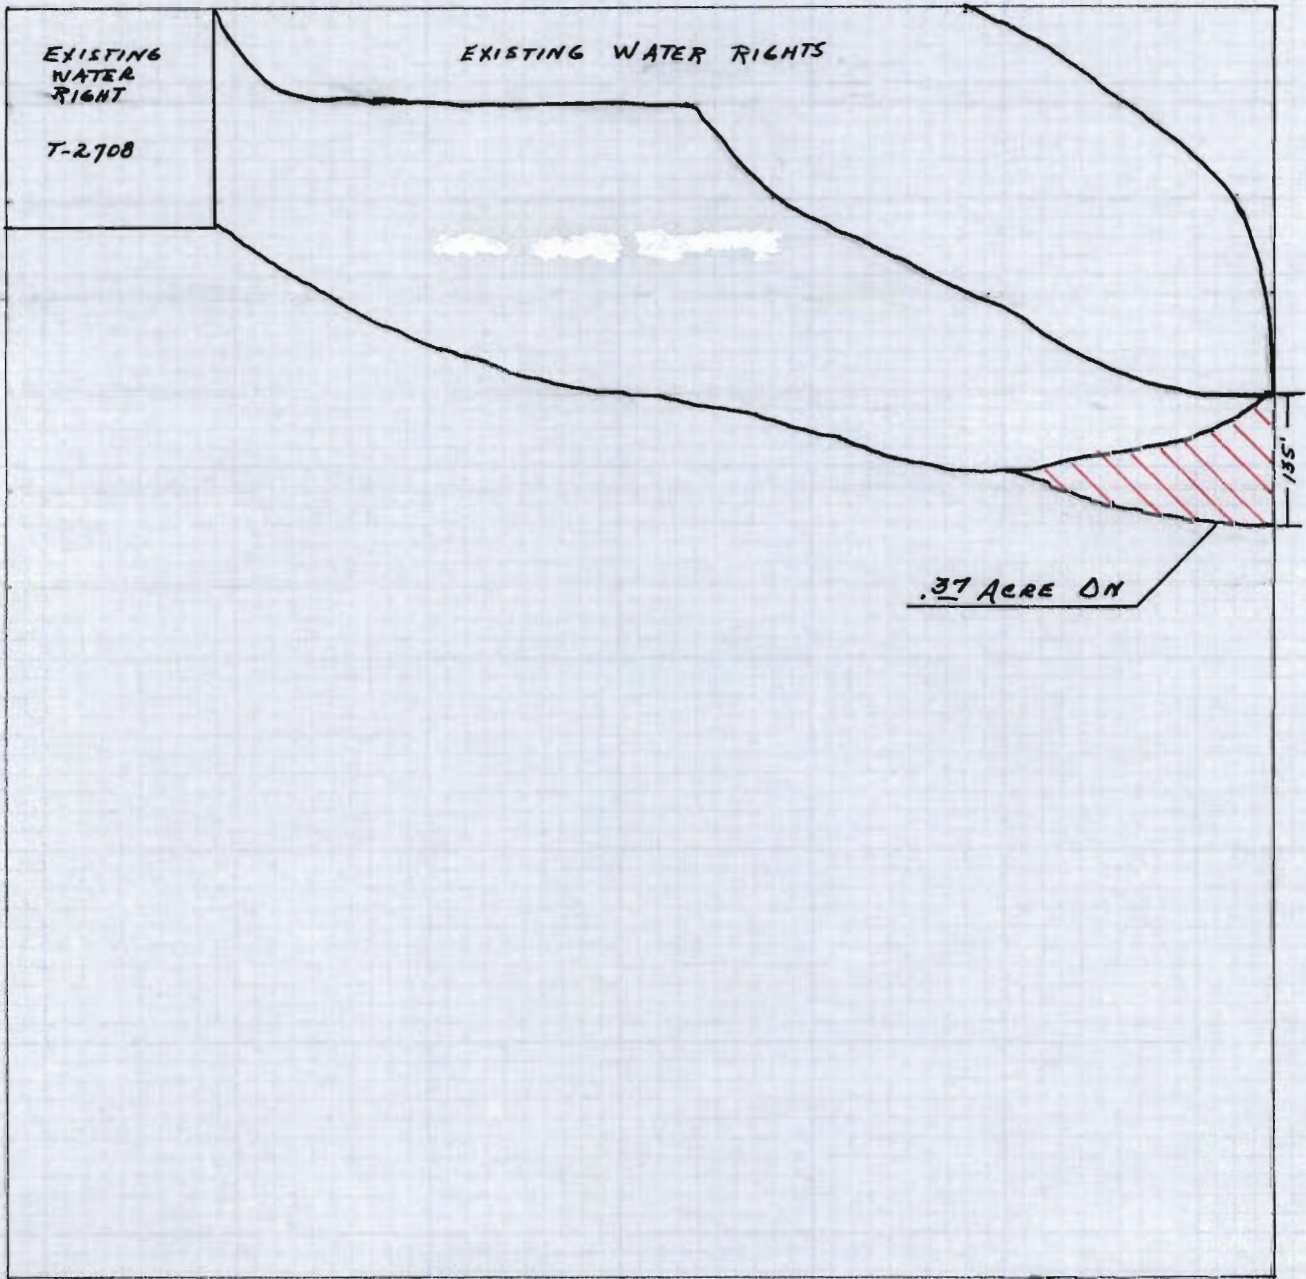

RECEIVED

SEP 21 1981

WATER RESOURCES DEPT
SALEM, OREGON