


# T. 25 S., R. 7 W., W.M.

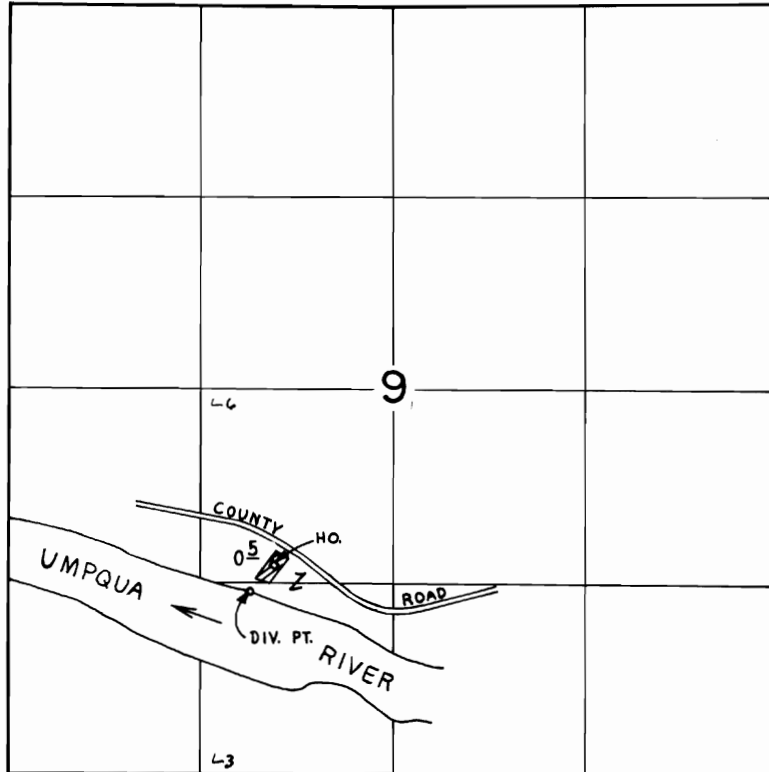

DIV. PT. LOCATED 1,400'S. & 1,660'E. FROM W. 1/4 COR. SEC. 9

SCALE: 4" = 1 mile

## FINAL PROOF SURVEY

UNDER

Application No. T-4904 Permit No. ....  
IN NAME OF

..... LYLE BOWEN .....

Surveyed FEB. 27, 1985, by L. CASHION...