


NI

RECEIVED

T-4909 OCT - 9 1987

WATER RESOURCES DEPT
SALEM, OREGON

TO map

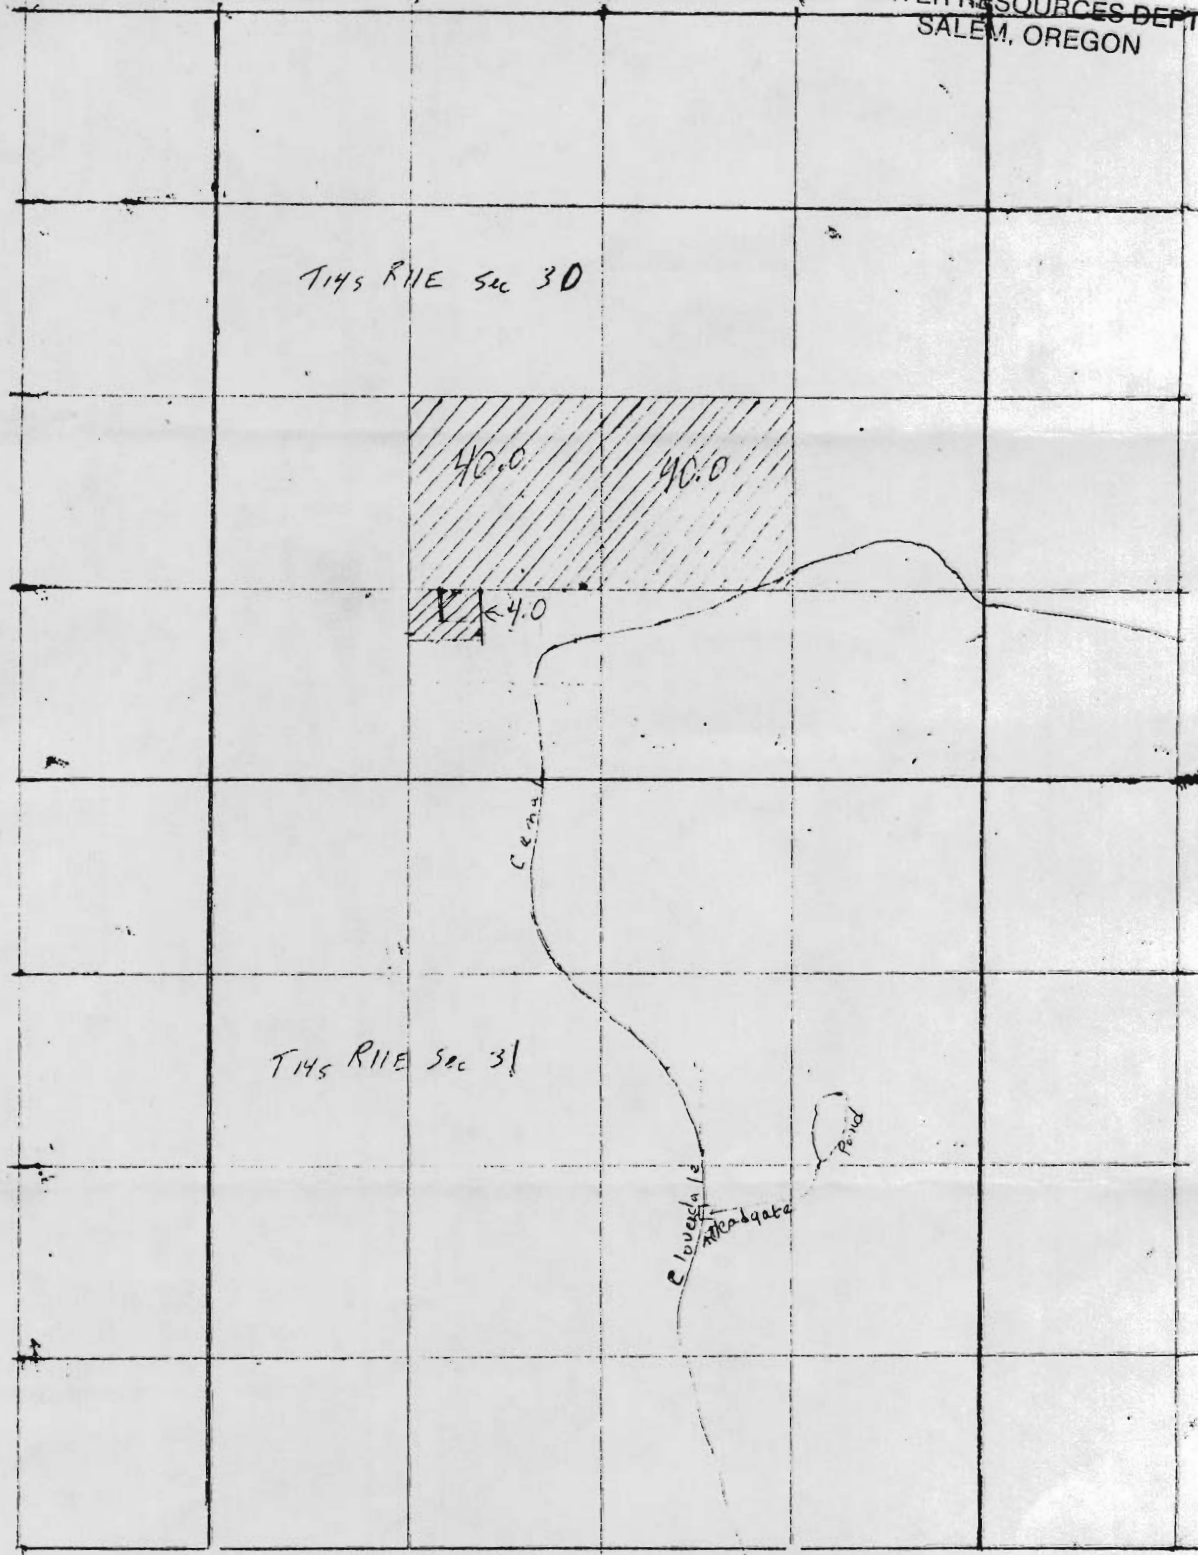

RECEIVED

OCT 2 1981

WATER RESOURCES DEPT
SALEM, OREGON

RECEIVED

OCT 27 1981

WATER RESOURCES DEPT
SALEM, OREGON

Transfer of 1899 Rights By ET Leason


map : 4" = 1 mi

RECEIVED
T-7900

OCT - 9 1987

WATER RESOURCES DEPT.
SALEM, OREGON

From Map

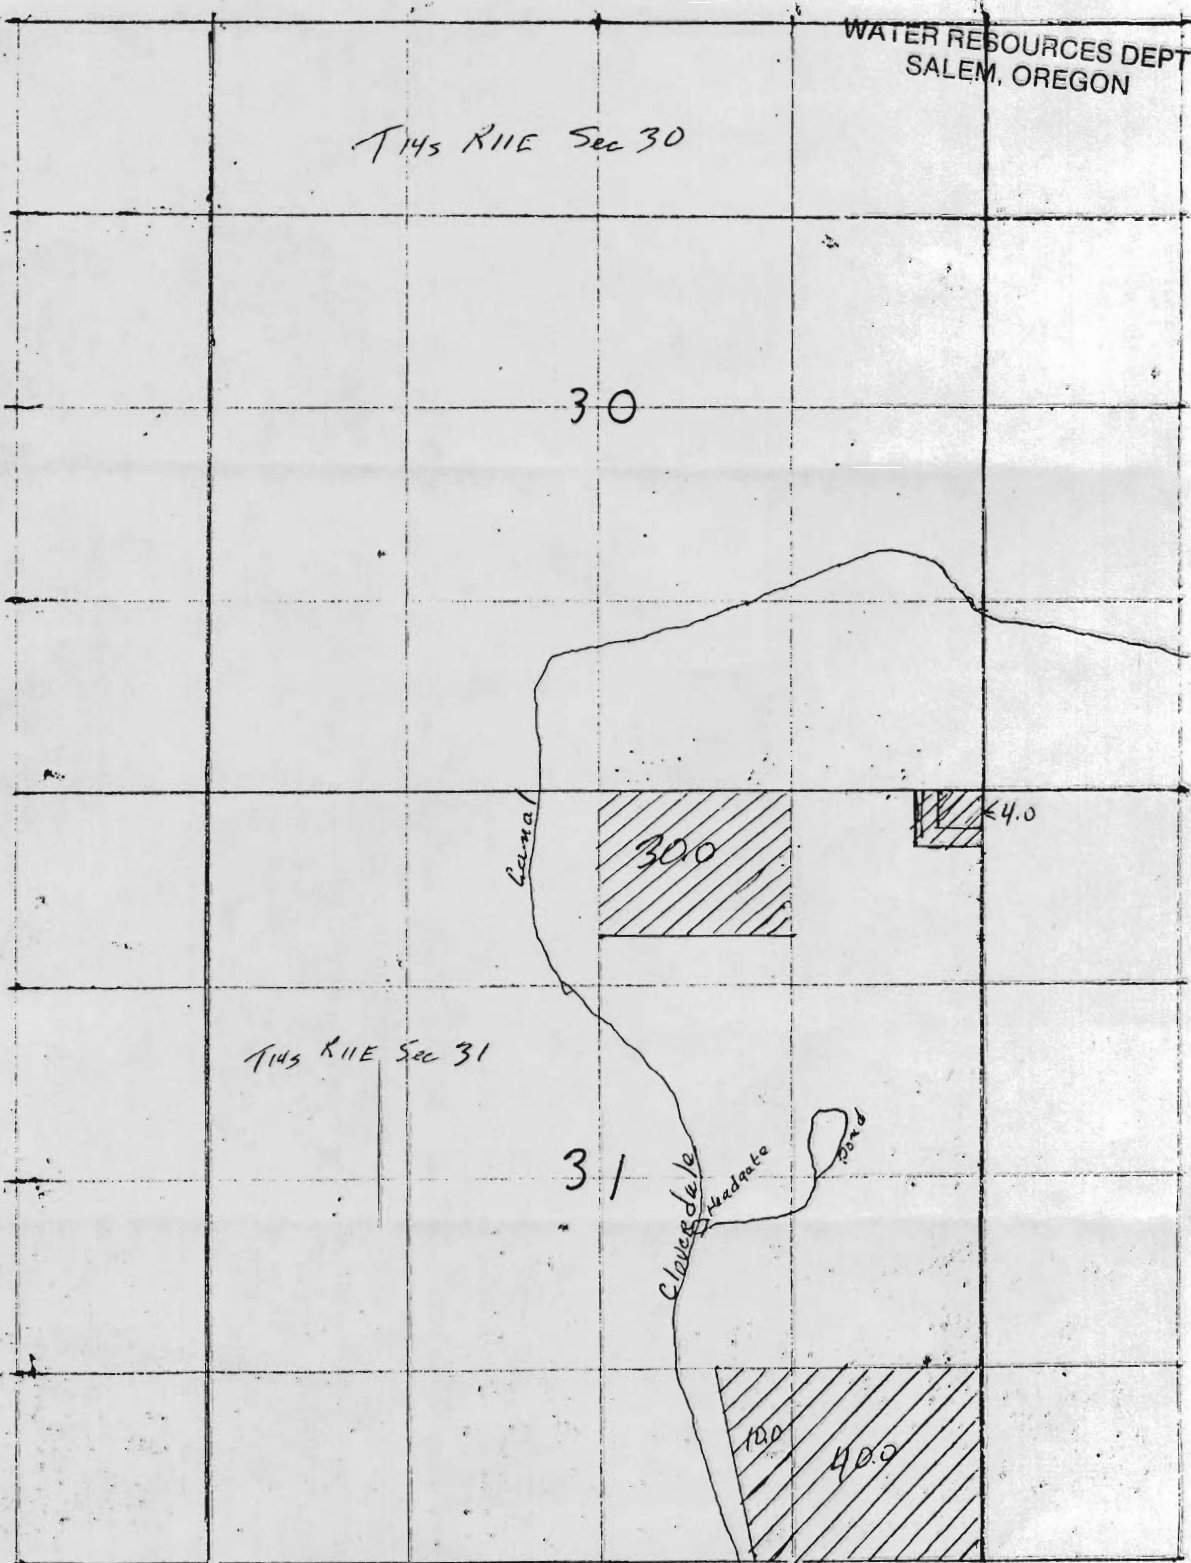

RECEIVED

OCT 27 1981

WATER RESOURCES DEPT.
SALEM, OREGON

Transfer of 1899 Rights by E.J. Leason

Map 4" = 1 mi