


T. 4S., R. 12E., W. M.

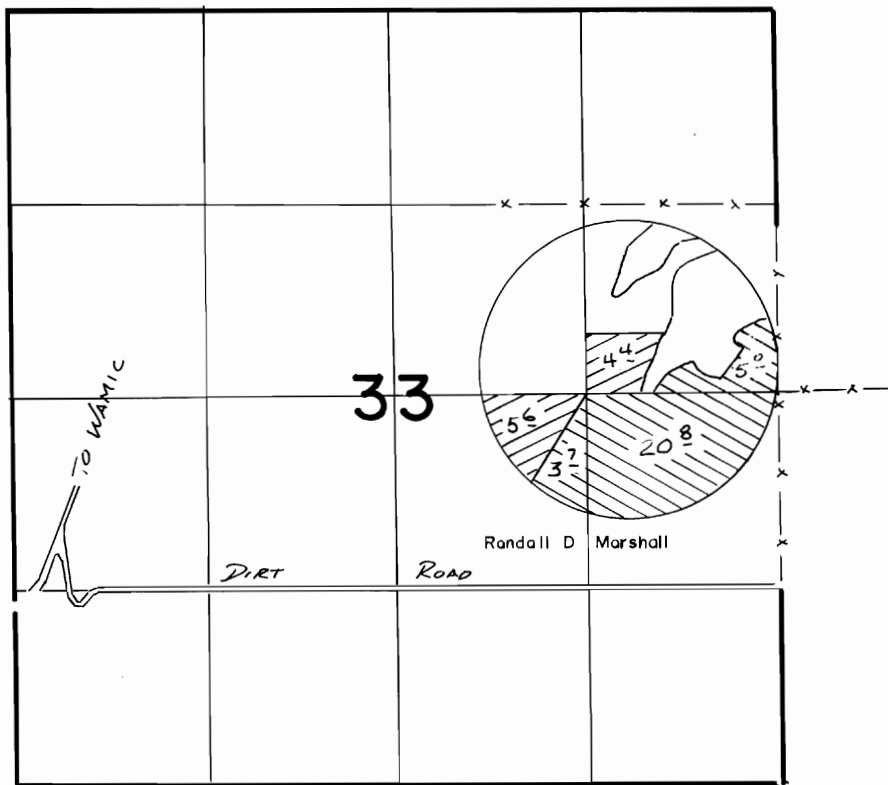

SCALE 1" = 1320'



1911



1901

**FINAL PROOF SURVEY**

UNDER

**TRANSFER 4913**

IN NAME OF

Lost & Boulder Ditch Company

Surveyed 10-19 19.88, by V. L. Church