


RECEIVED

OCT 8 1981

WATER RESOURCES DEPT
SALEM, OREGON

T-4918

SCALE: 1"=400'

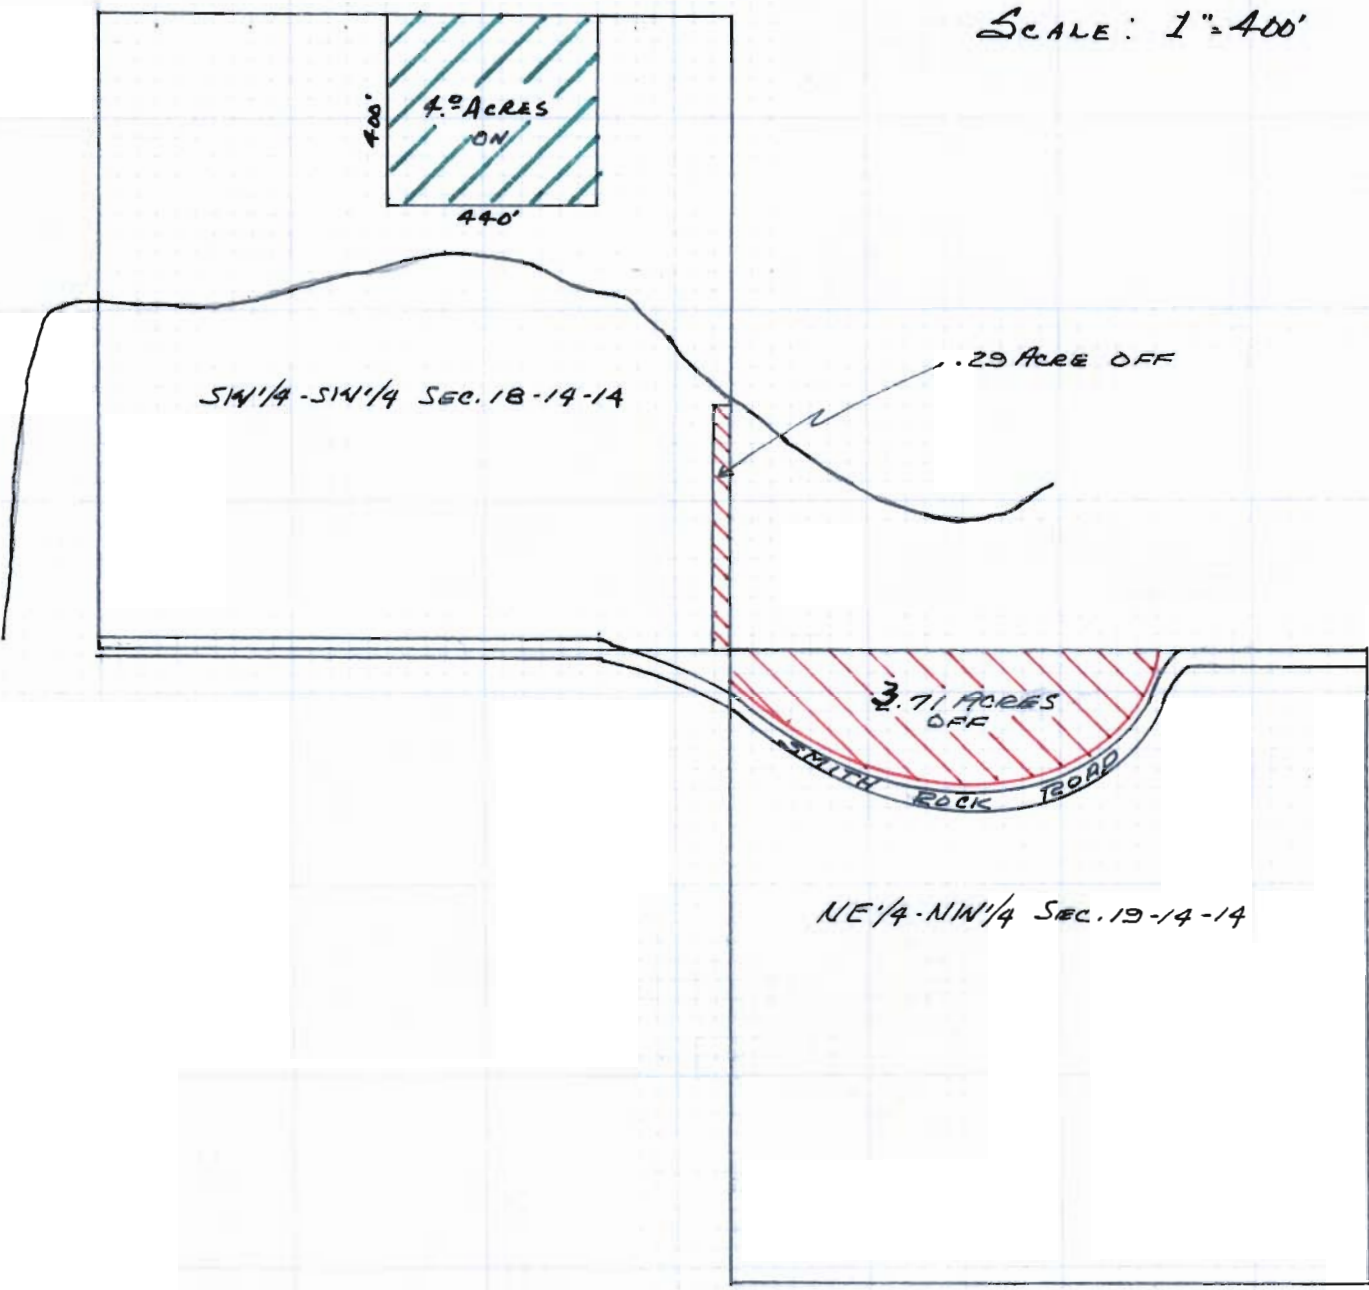


T-4918

RECEIVED

001 400 81981

WATER RESOURCES DEPT
WALLEN, OREGON

DESCHUTES

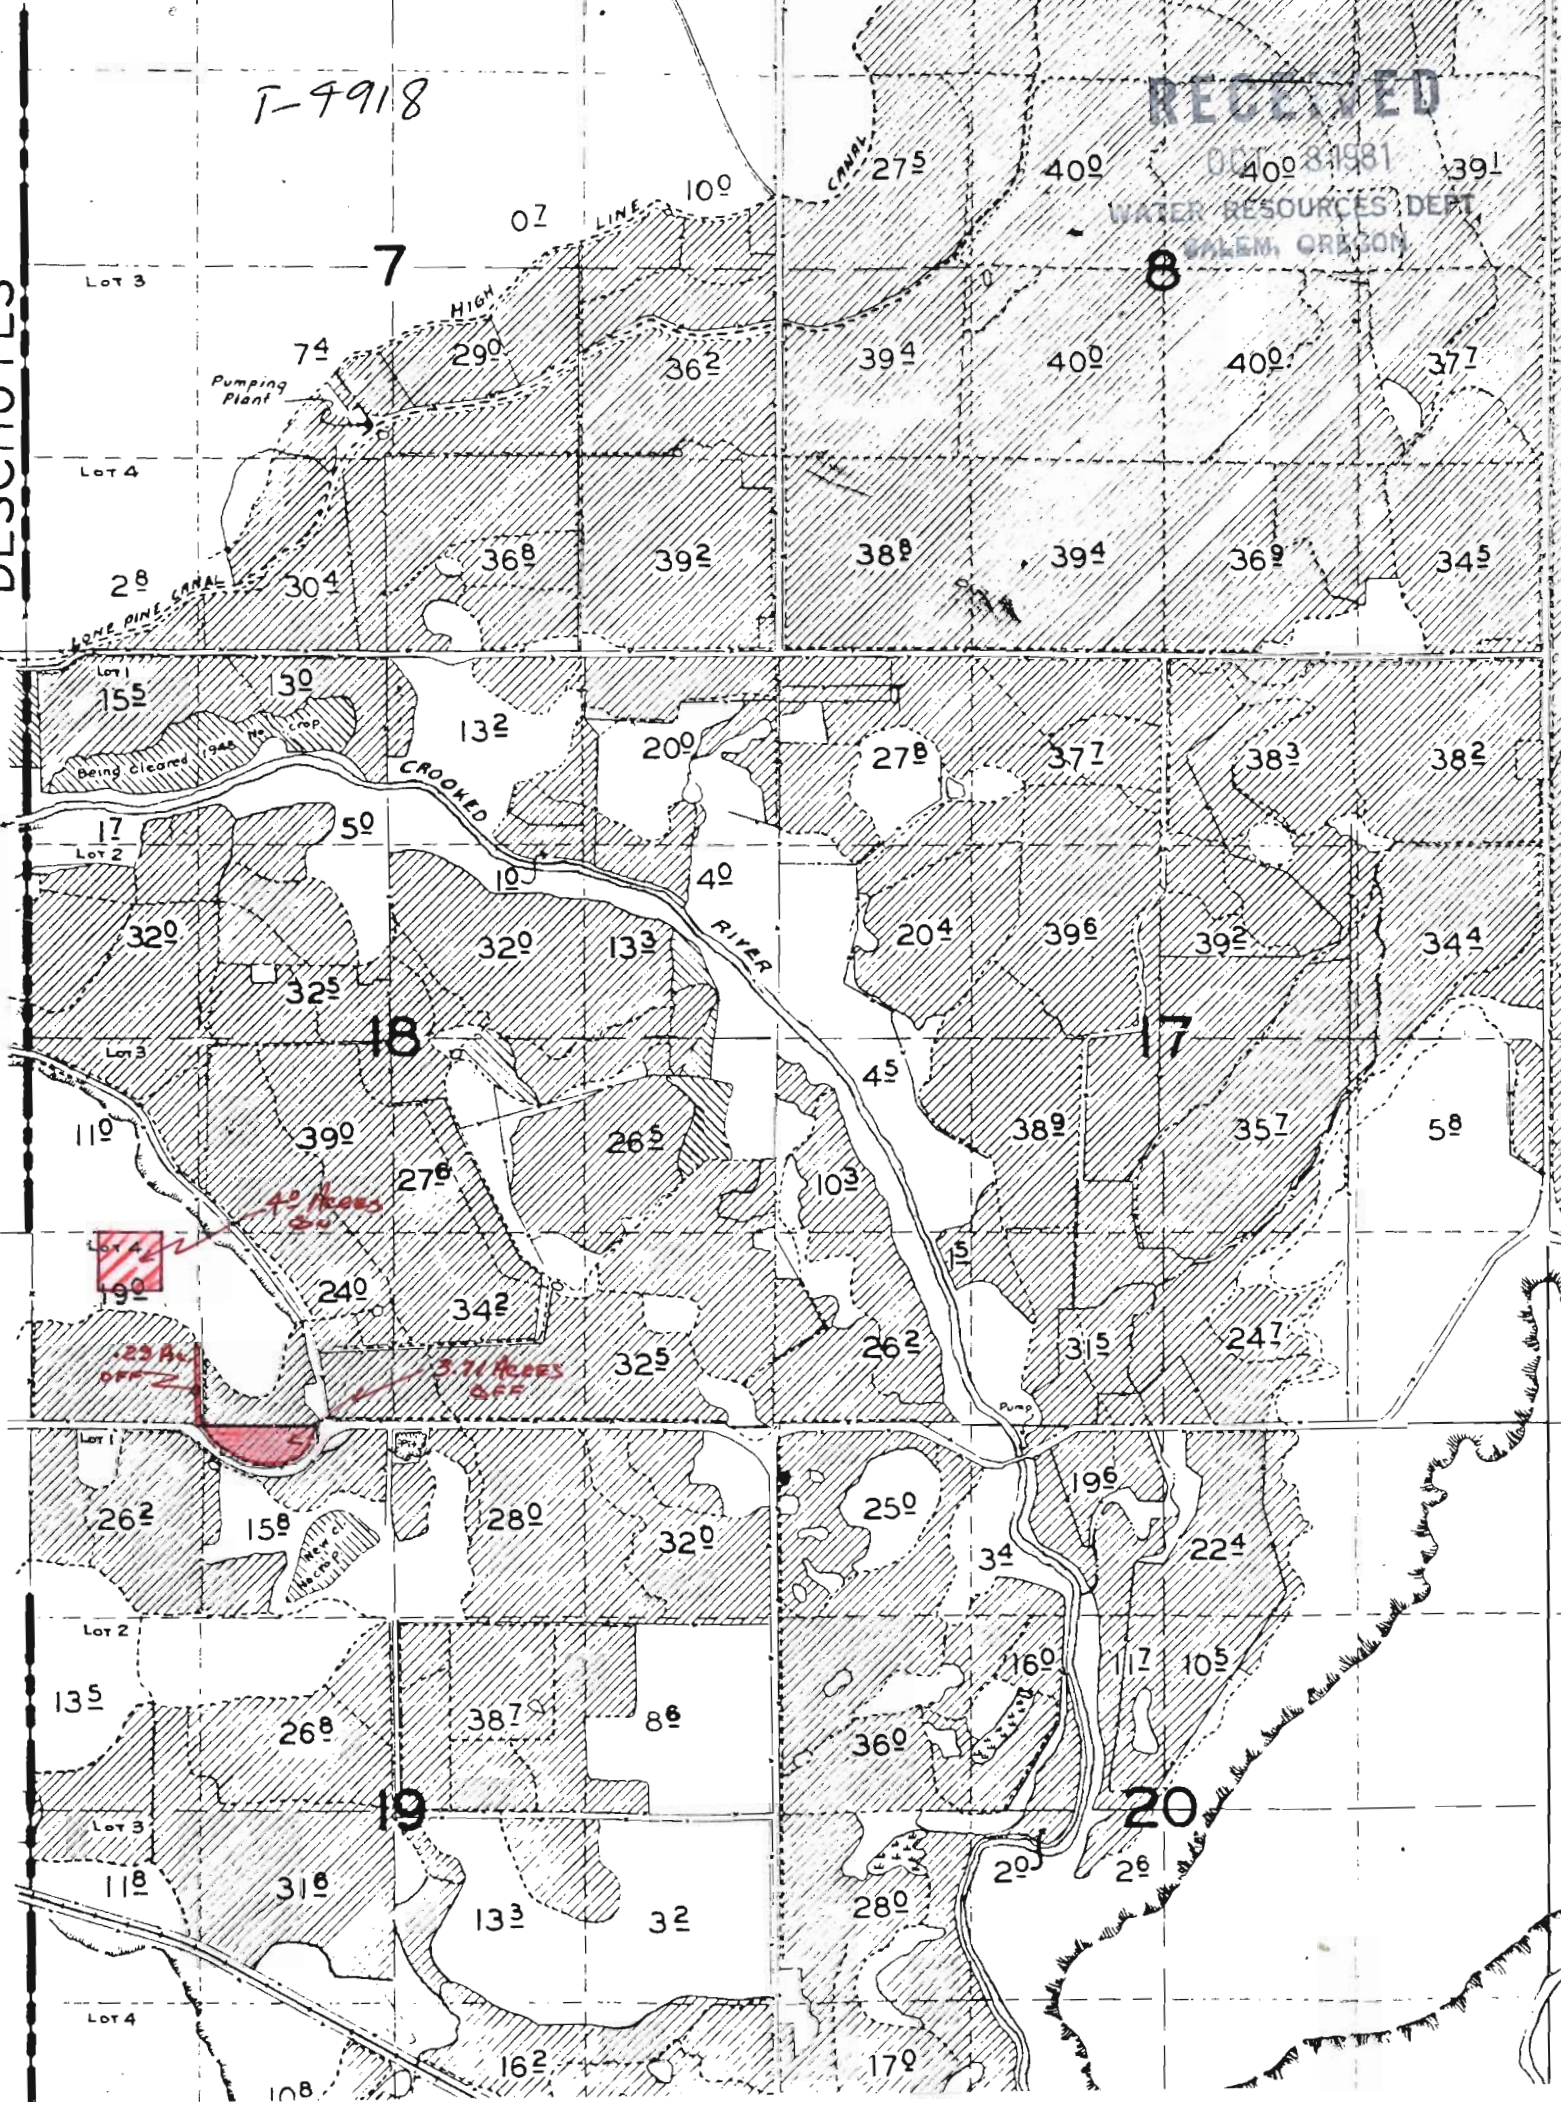

7

8

18

17

19

20

Pumping Plant

CROOKED RIVER

CANAL

HIGH LINE

Lot 3

Lot 4

Lot 1

Lot 2

Lot 3

Lot 1

Lot 2

Lot 3

Lot 4

ONE PINE CANAL

Being Cleared

.23 AC OFF


3.71 Acres OFF


Pump

118

318

133

32

162

170

280

200

26

280

170

200

26

224

105

117

160

360

262

158

280

320

250

196

34

224

250

103

389

315

247

357

58

344

392

396

110

390

278

262

103

45

389

357

262

204

396

392

344

204

371

383

382

382

320

325

320

133

40

200

278












28

304

368

392

388

394

369

345











74

290

362

394

400

400

400

371

394










07

100

275

400

391


































































































































































































