


21

N.W. 8TH

N.W. 8TH

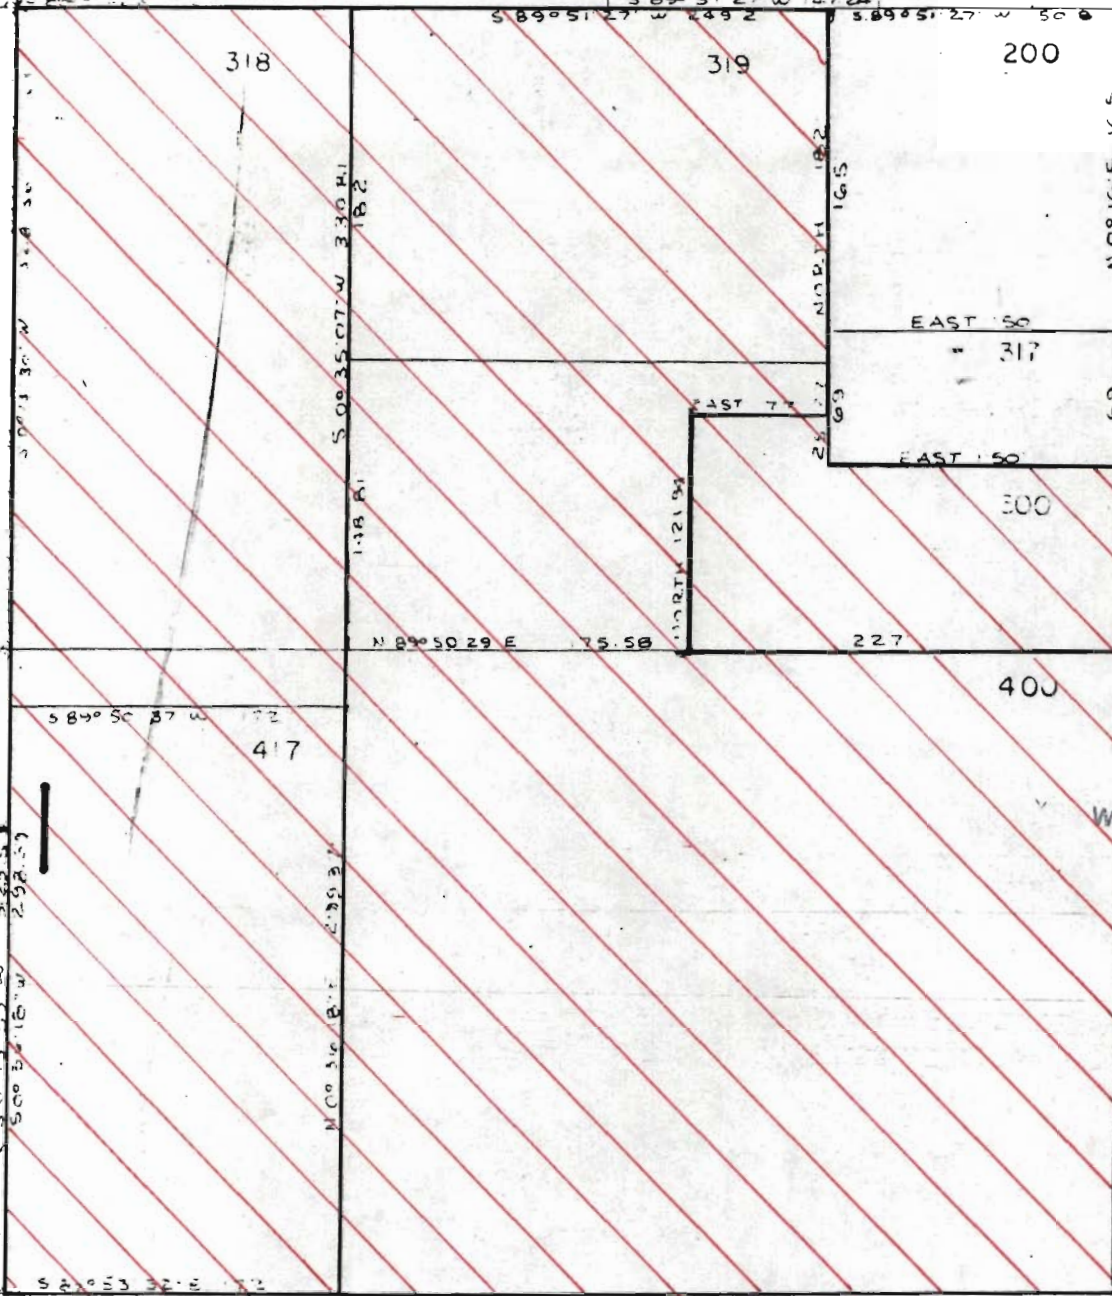

8⁰⁰ ACRES OFF

RECEIVED

SEP 17 1981

WATER RESOURCES DEPT. SALEM, OREGON

RECEIVED

OCT 16 1981

WATER RESOURCES DEPT. SALEM, OREGON

DALLES CALIFORNIA


HIGHWAY

T-4920

AVENUE

NW 1/4 NE 1/4 SEC. 9 T. 15S R. 13 E. WM

SCALE: 1" = 100'

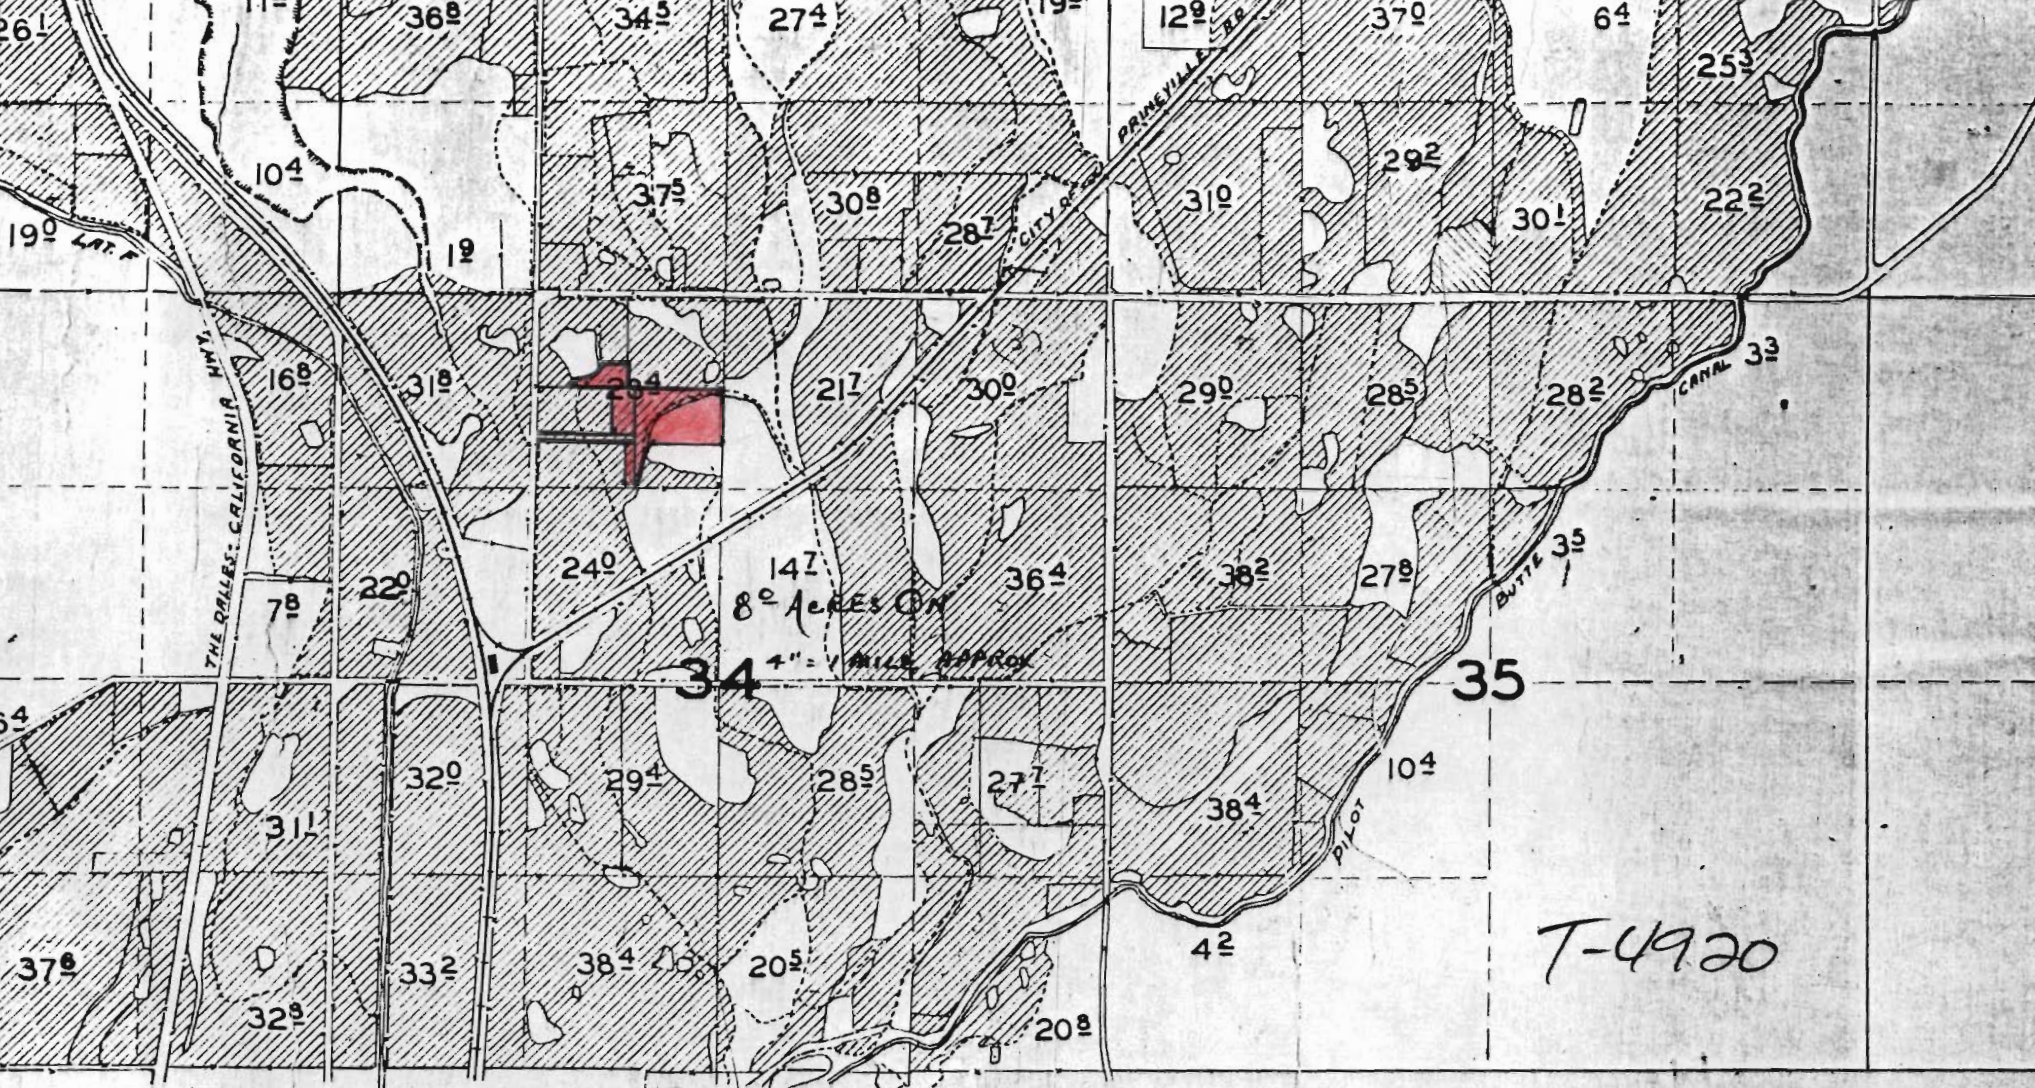

RECEIVED

SEP 1 1961

WATER RESOURCES DEPT
SALES, OREGON

RECEIVED

OCT 16 1961

WATER RESOURCES DEPT
SALES, OREGON

SURVEYED SEPT 22-30, OCT 1, 2, 5, 6, 7, 1947 JULY 24, 25,

T-4920



T-4920

REDMOND

RECEIVED
JUN 16 1984
WATER RESOURCES DEPT.
SALEM OREGON

THE DALES CALIFORNIA HIGHWAY

SALUBRITY CANAL


MILL POND

17 HIGHWAY

16

15

KENZIE