


T.37 S., R.9 W., W.M.

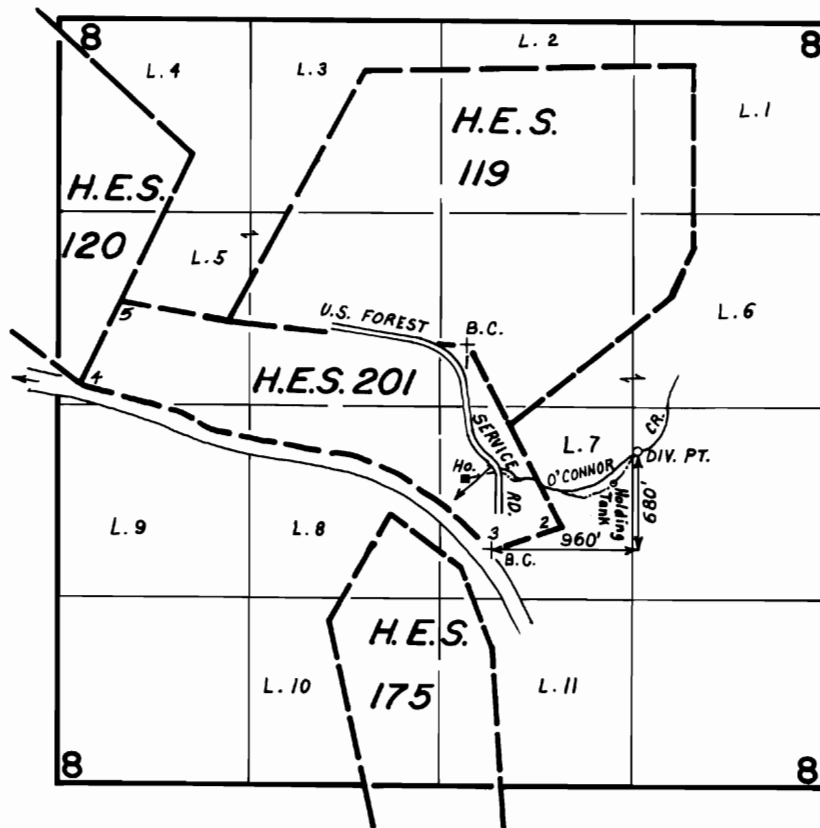

SCALE: 1" = 1320'

FINAL PROOF SURVEY
UNDER

TRANSFER NO. 4924

Application No. Permit No.
IN NAME OF

..... **J. ROBERT EGAN**

Surveyed **MAR. 2** 19**84**, by **B. S. JAMES**