


T. 9S. R. 40E. W. M.

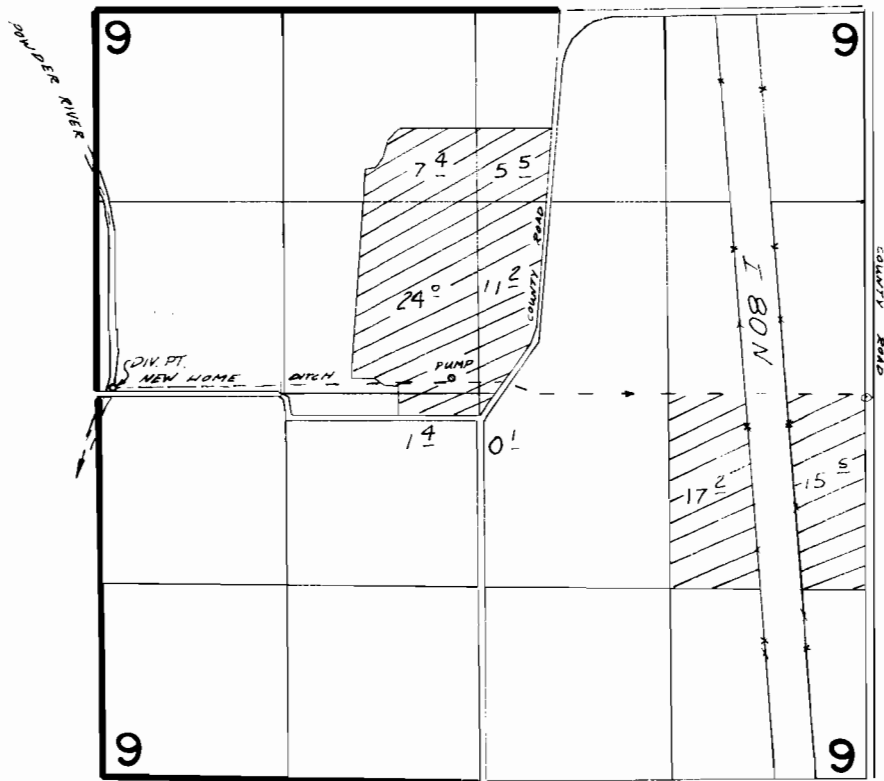

FINAL PROOF SURVEY
UNDER

B-14
TRANSFER B-51

Application No. _____ Permit No. _____
IN NAME OF

FRANK BAIRD

Surveyed 5-23 1956 by M. BISH
7-26 79 V. CHURCH & D. JARRETT