


16-11-13

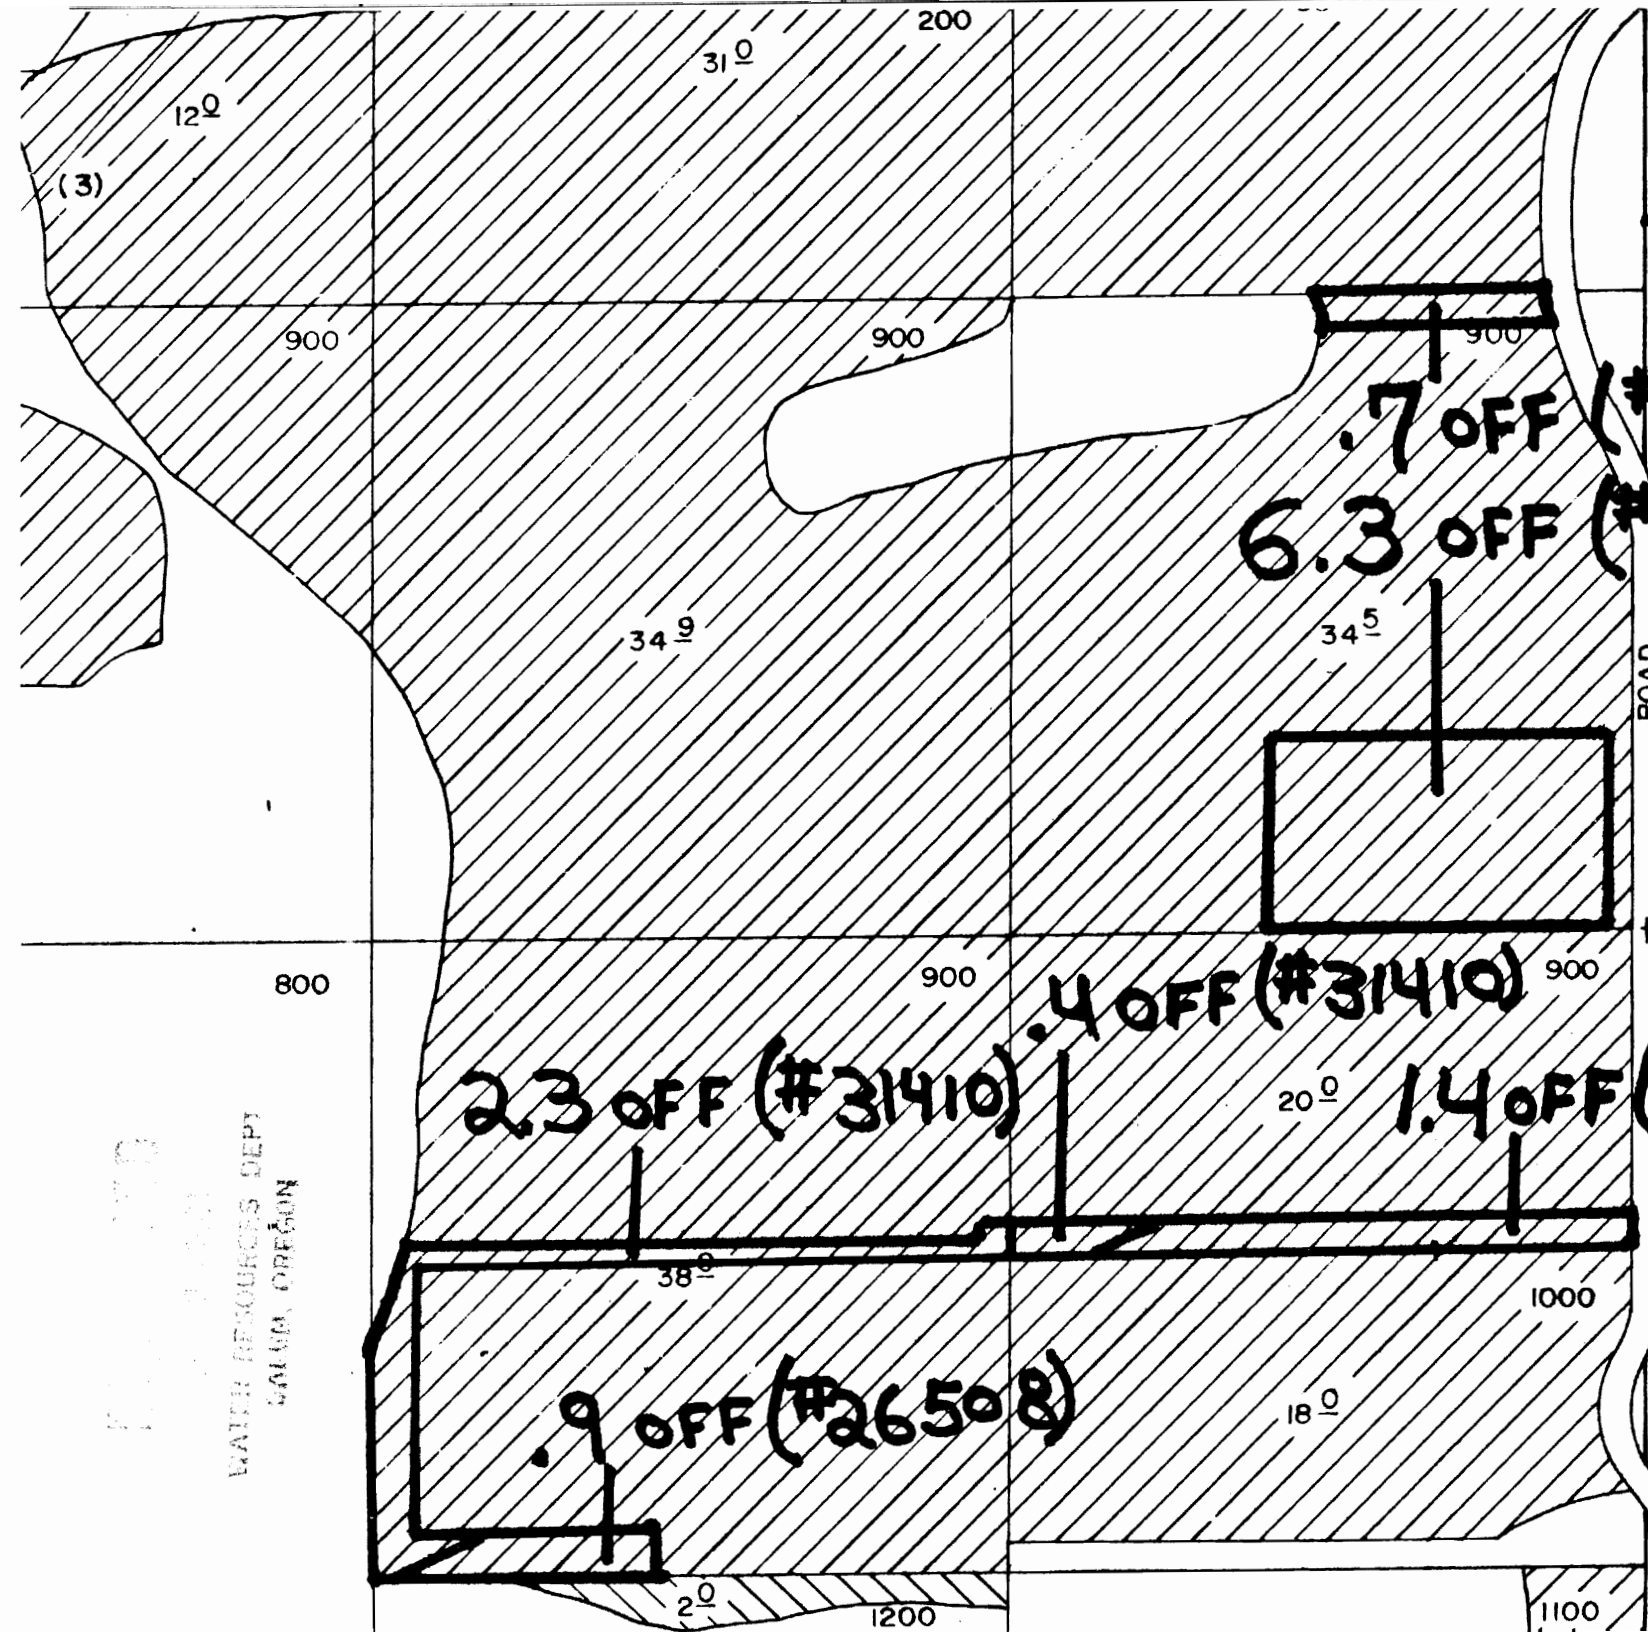

WATER RESOURCES DEPT
SALEM, OREGON

ROAD

.7 OFF (#31410)

6.3 OFF (#31410)

T-4935

2.3 OFF (#31410)

.4 OFF (#31410)

1.4 OFF (#26508)

.9 OFF (#26508)