
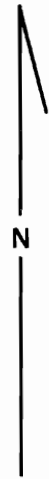


T.16S., R.11E., W.M.

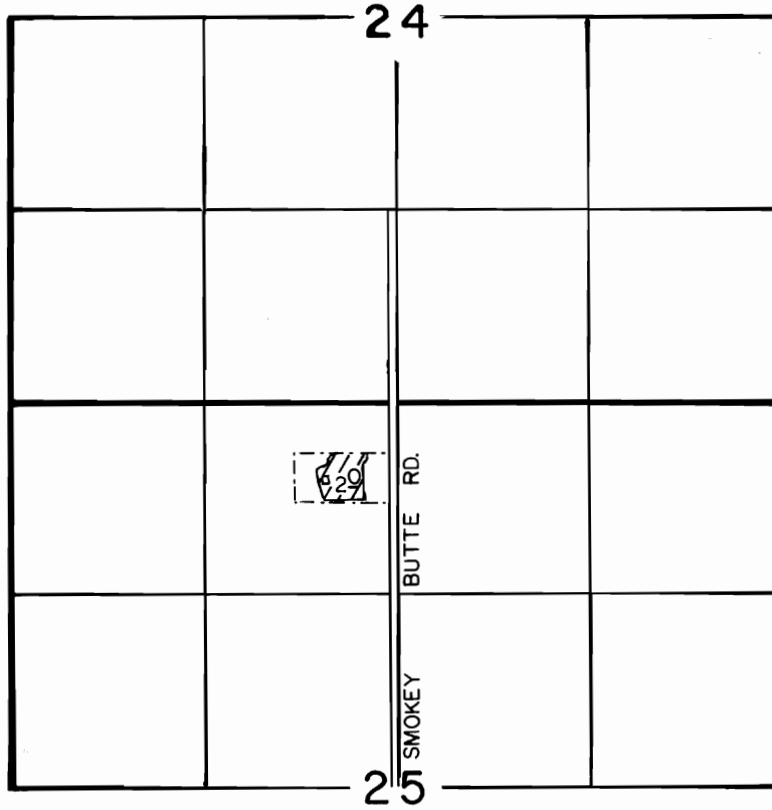

SCALE : 1"=1320

FINAL PROOF SURVEY
UNDER

TRANSFER NO. 4937

IN NAME OF

WAYNE A. NEILL

Surveyed OCT. 18, 1985, by LESLIE OLSON