


T. 30 S., R. 5 W., W.M.

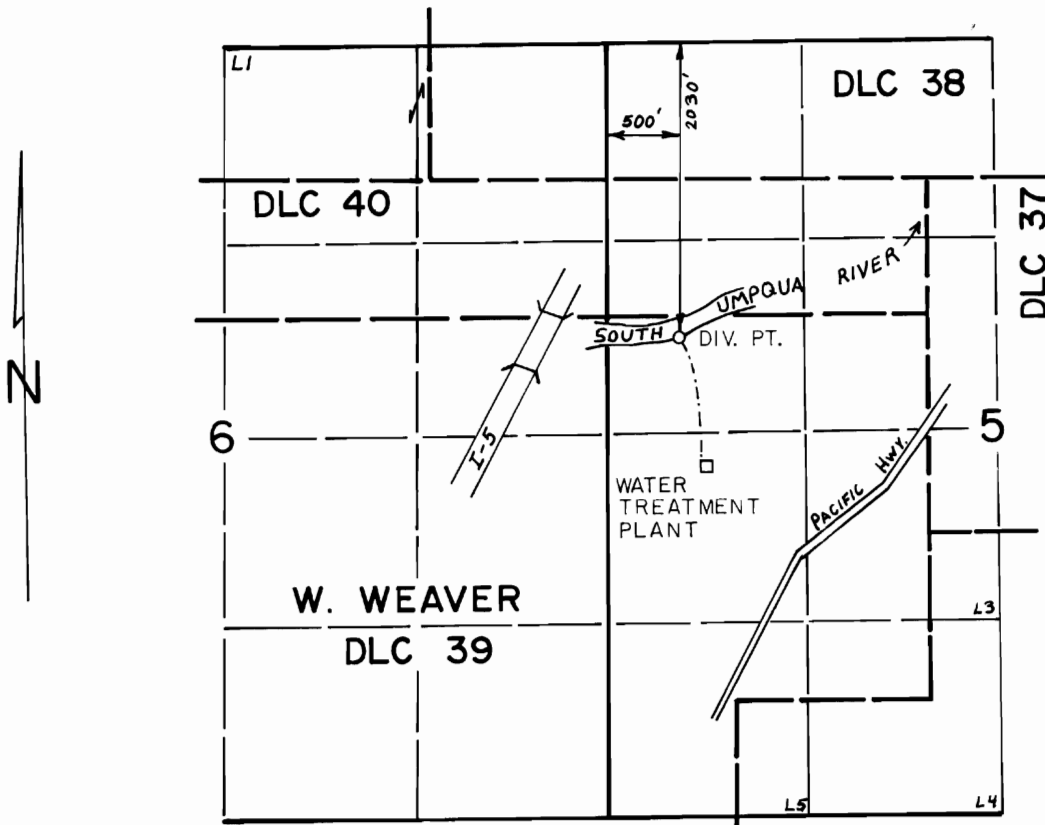

SCALE: 4" = 1 mile

FINAL PROOF SURVEY
UNDER

Application No. T-4941 Permit No.
IN NAME OF

TRI-CITY WATER DISTRICT

Surveyed MAY 24 1984, by *L.E. Cashier*