


T. 29 S. R. 4 W. W.M.

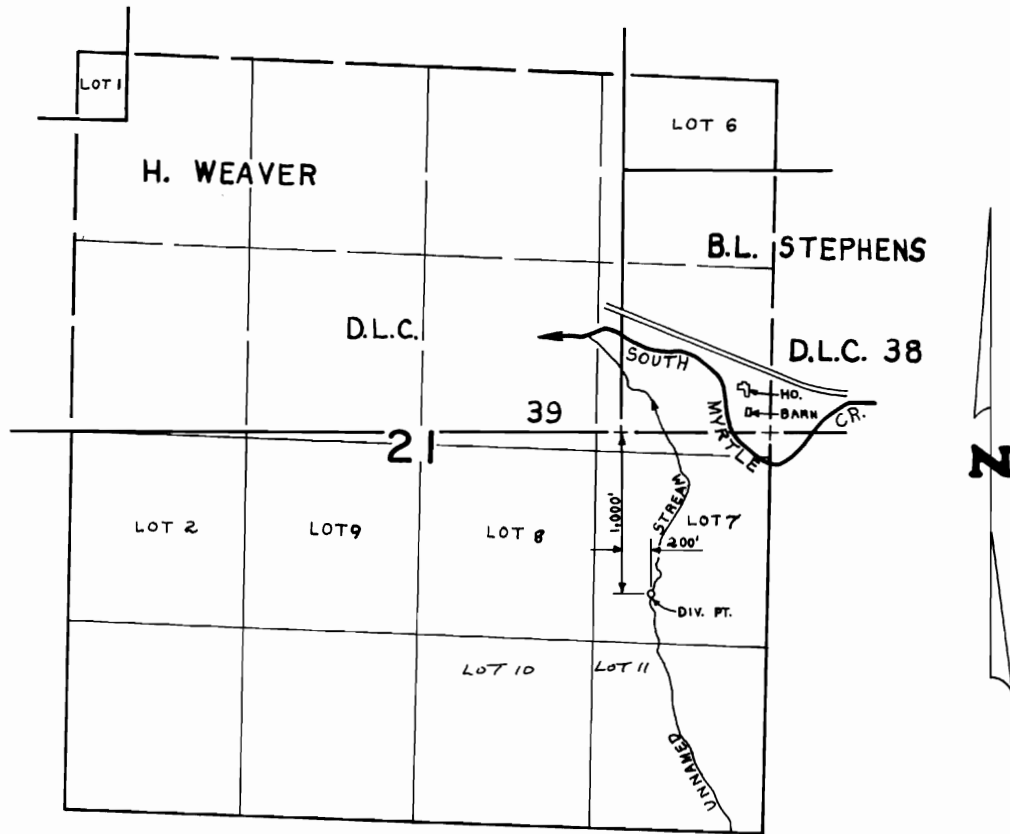

SCALE: 4" = 1 mile

FINAL PROOF SURVEY UNDER

Application No. T. 4961. Permit No.
IN NAME OF

FRANK P. & CLARA A. MOAN

Surveyed DEC. 3. 1983, by L. CASHION...