




T. 16S., R. 11E., W.M.

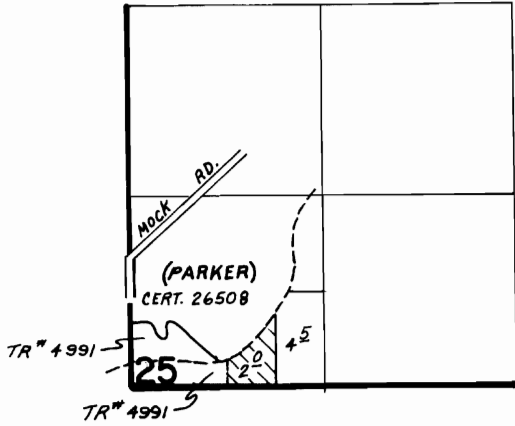


T. 17S., R. 11E., W.M.

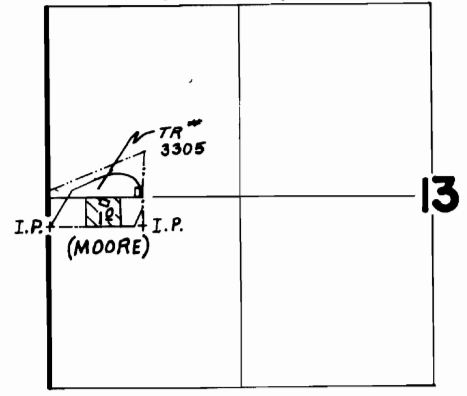

T. 16S., R. 11E., W.M.

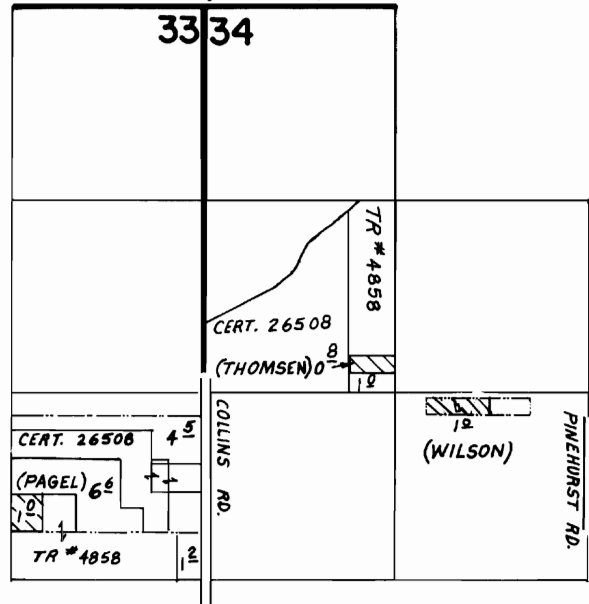

T. 16S., R. 11E., W.M.
28

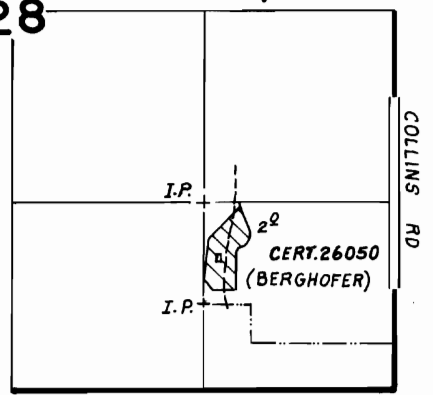

SCALE : 1" = 1320'

FINAL PROOF SURVEY

UNDER

TRANSFER NO. 4967

Application No. Permit No.
IN NAME OF

.....**BERGHOFER, et al.**.....

Surveyed AUG. 21, 1984, by LESLIE OLSON...