


# T.18S.,R.46E.,W.M.

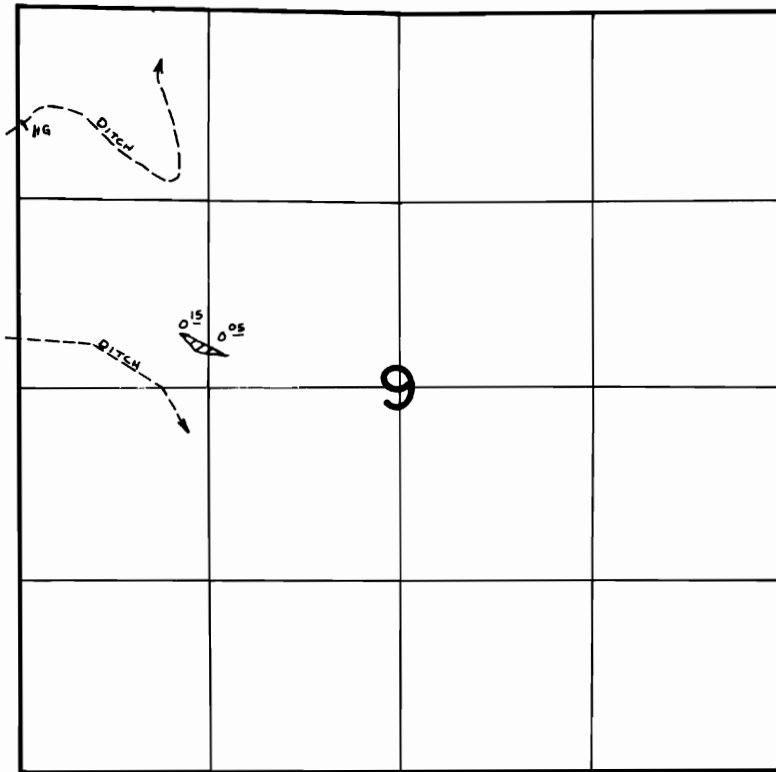

## FINAL PROOF SURVEY UNDER

Transfer No. 4974  
Application No. .... Permit No. ....  
IN NAME OF

..... **ROBERT W. MELTON** .....

Surveyed Aug. 25... 1983., by J. L. M. TOLL.....