


T.4S. R.14E. W.M.

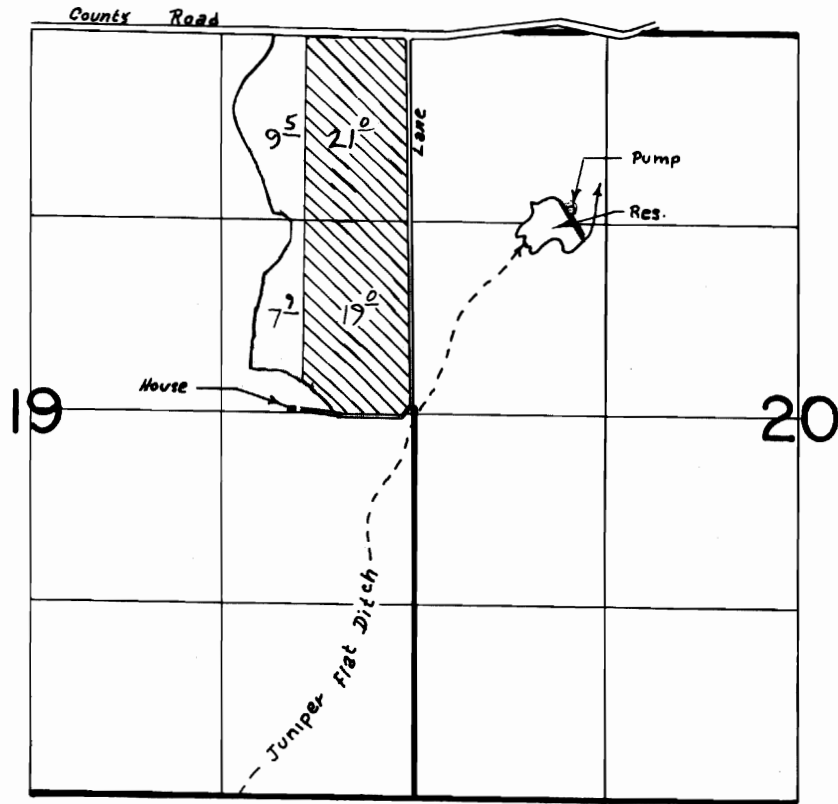


**FINAL PROOF SURVEY**  
UNDER

Transfer No. 4977 1/2  
Application No. .... Permit No. ....  
IN NAME OF

**GLENN CHASTAIN**

Surveyed Nov. 7 1984, by T. Paul

T. 4S. R. 13E. W.M.

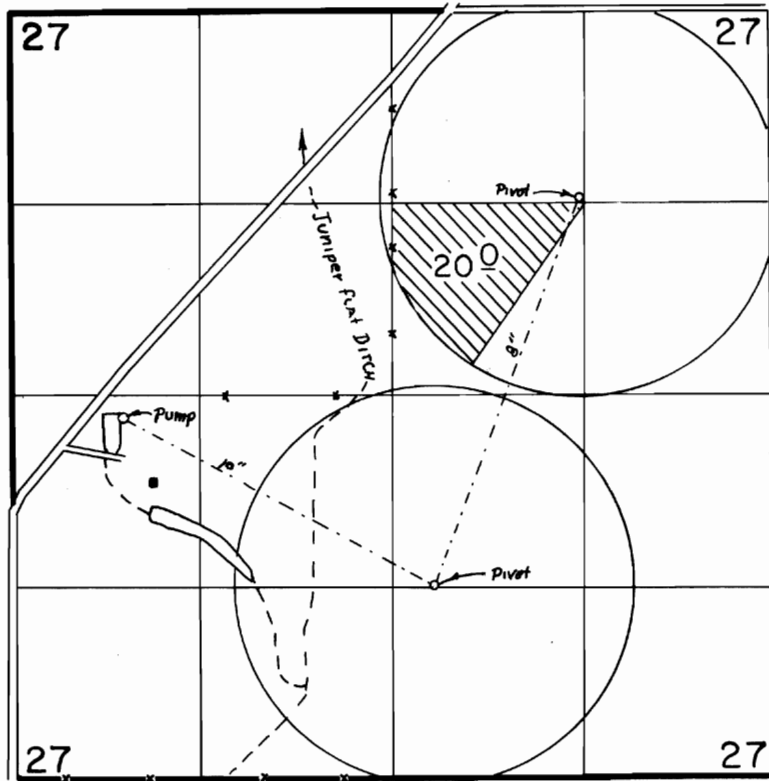

**FINAL PROOF SURVEY**  
UNDER

Transfer No. 4977 2/2  
Application No. \_\_\_\_\_ Permit No. \_\_\_\_\_  
IN NAME OF

.....TIM & TONY MORELLI.....

Surveyed Sep. 18 1985, by T. Paul.....