

RECEIVED

OCT 19 1983


WATER RESOURCES DEPT.
SALEM, OREGON

.21 ACRE ON
4" = 1 MILE APPROX.

W/R REMOVED BY
G-79

F-4986
Amended

BUTTE

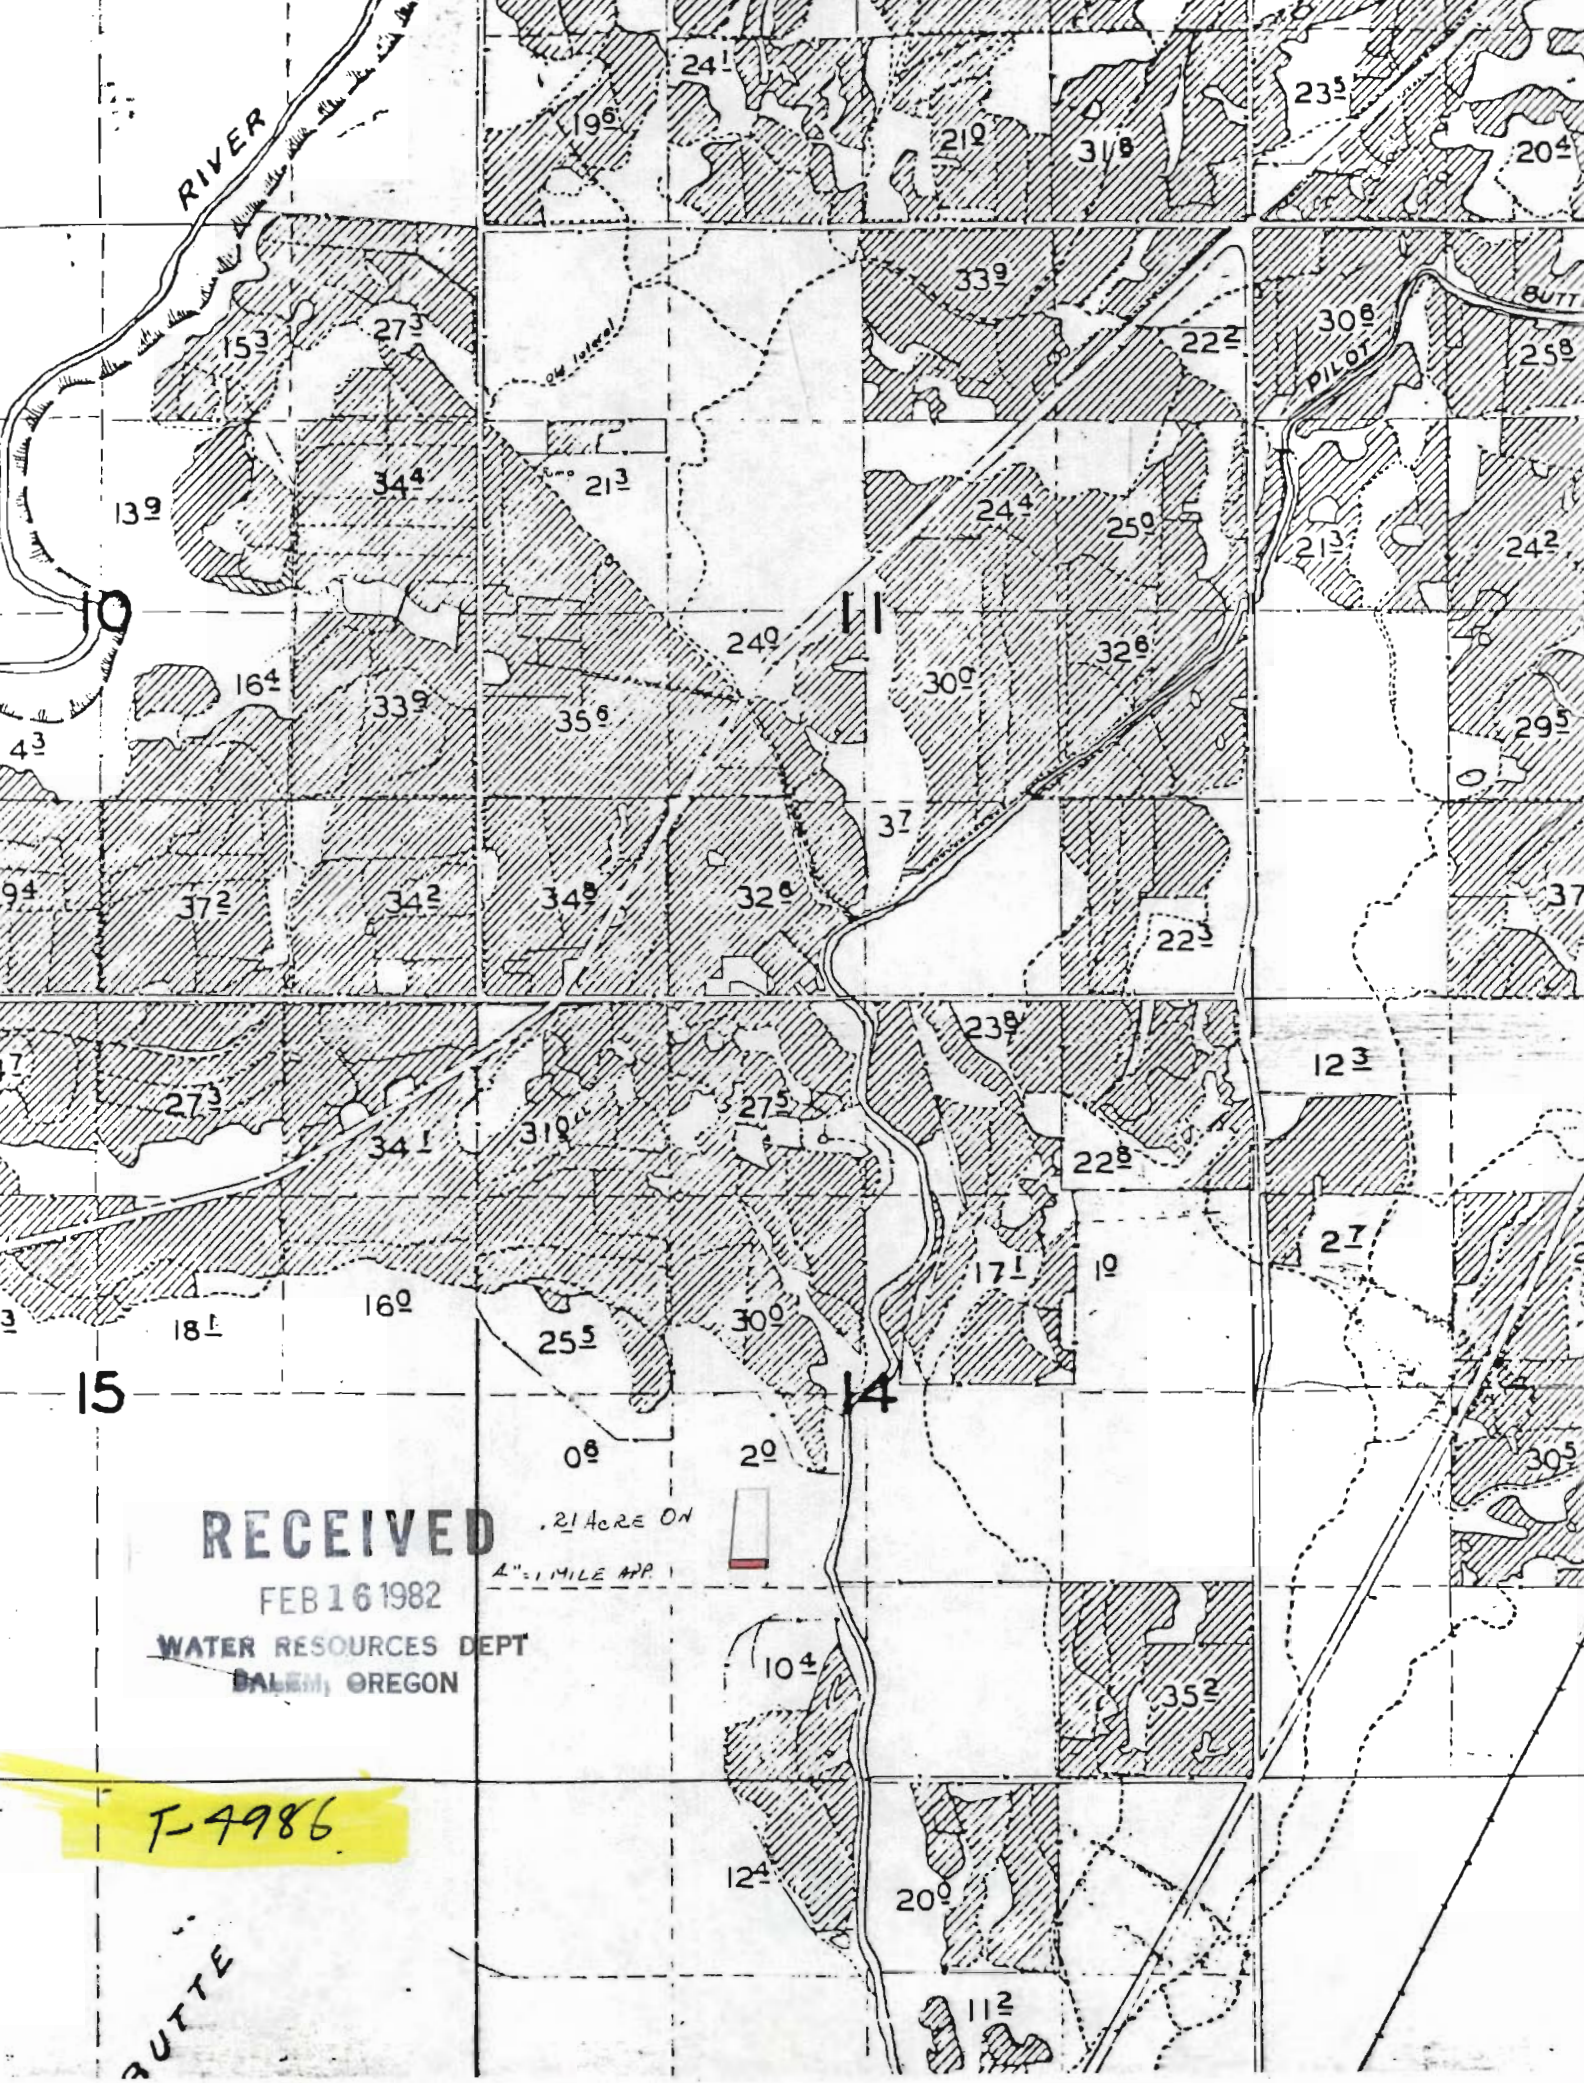

RIVER

RECEIVED

FEB 16 1982

WATER RESOURCES DEPT
SALEM, OREGON

T-4986



.21 ACRES ON



PILOT

BUTTE

RECEIVED
T-284-82
WATER RESOURCES DEPT
SALMON, OREGON

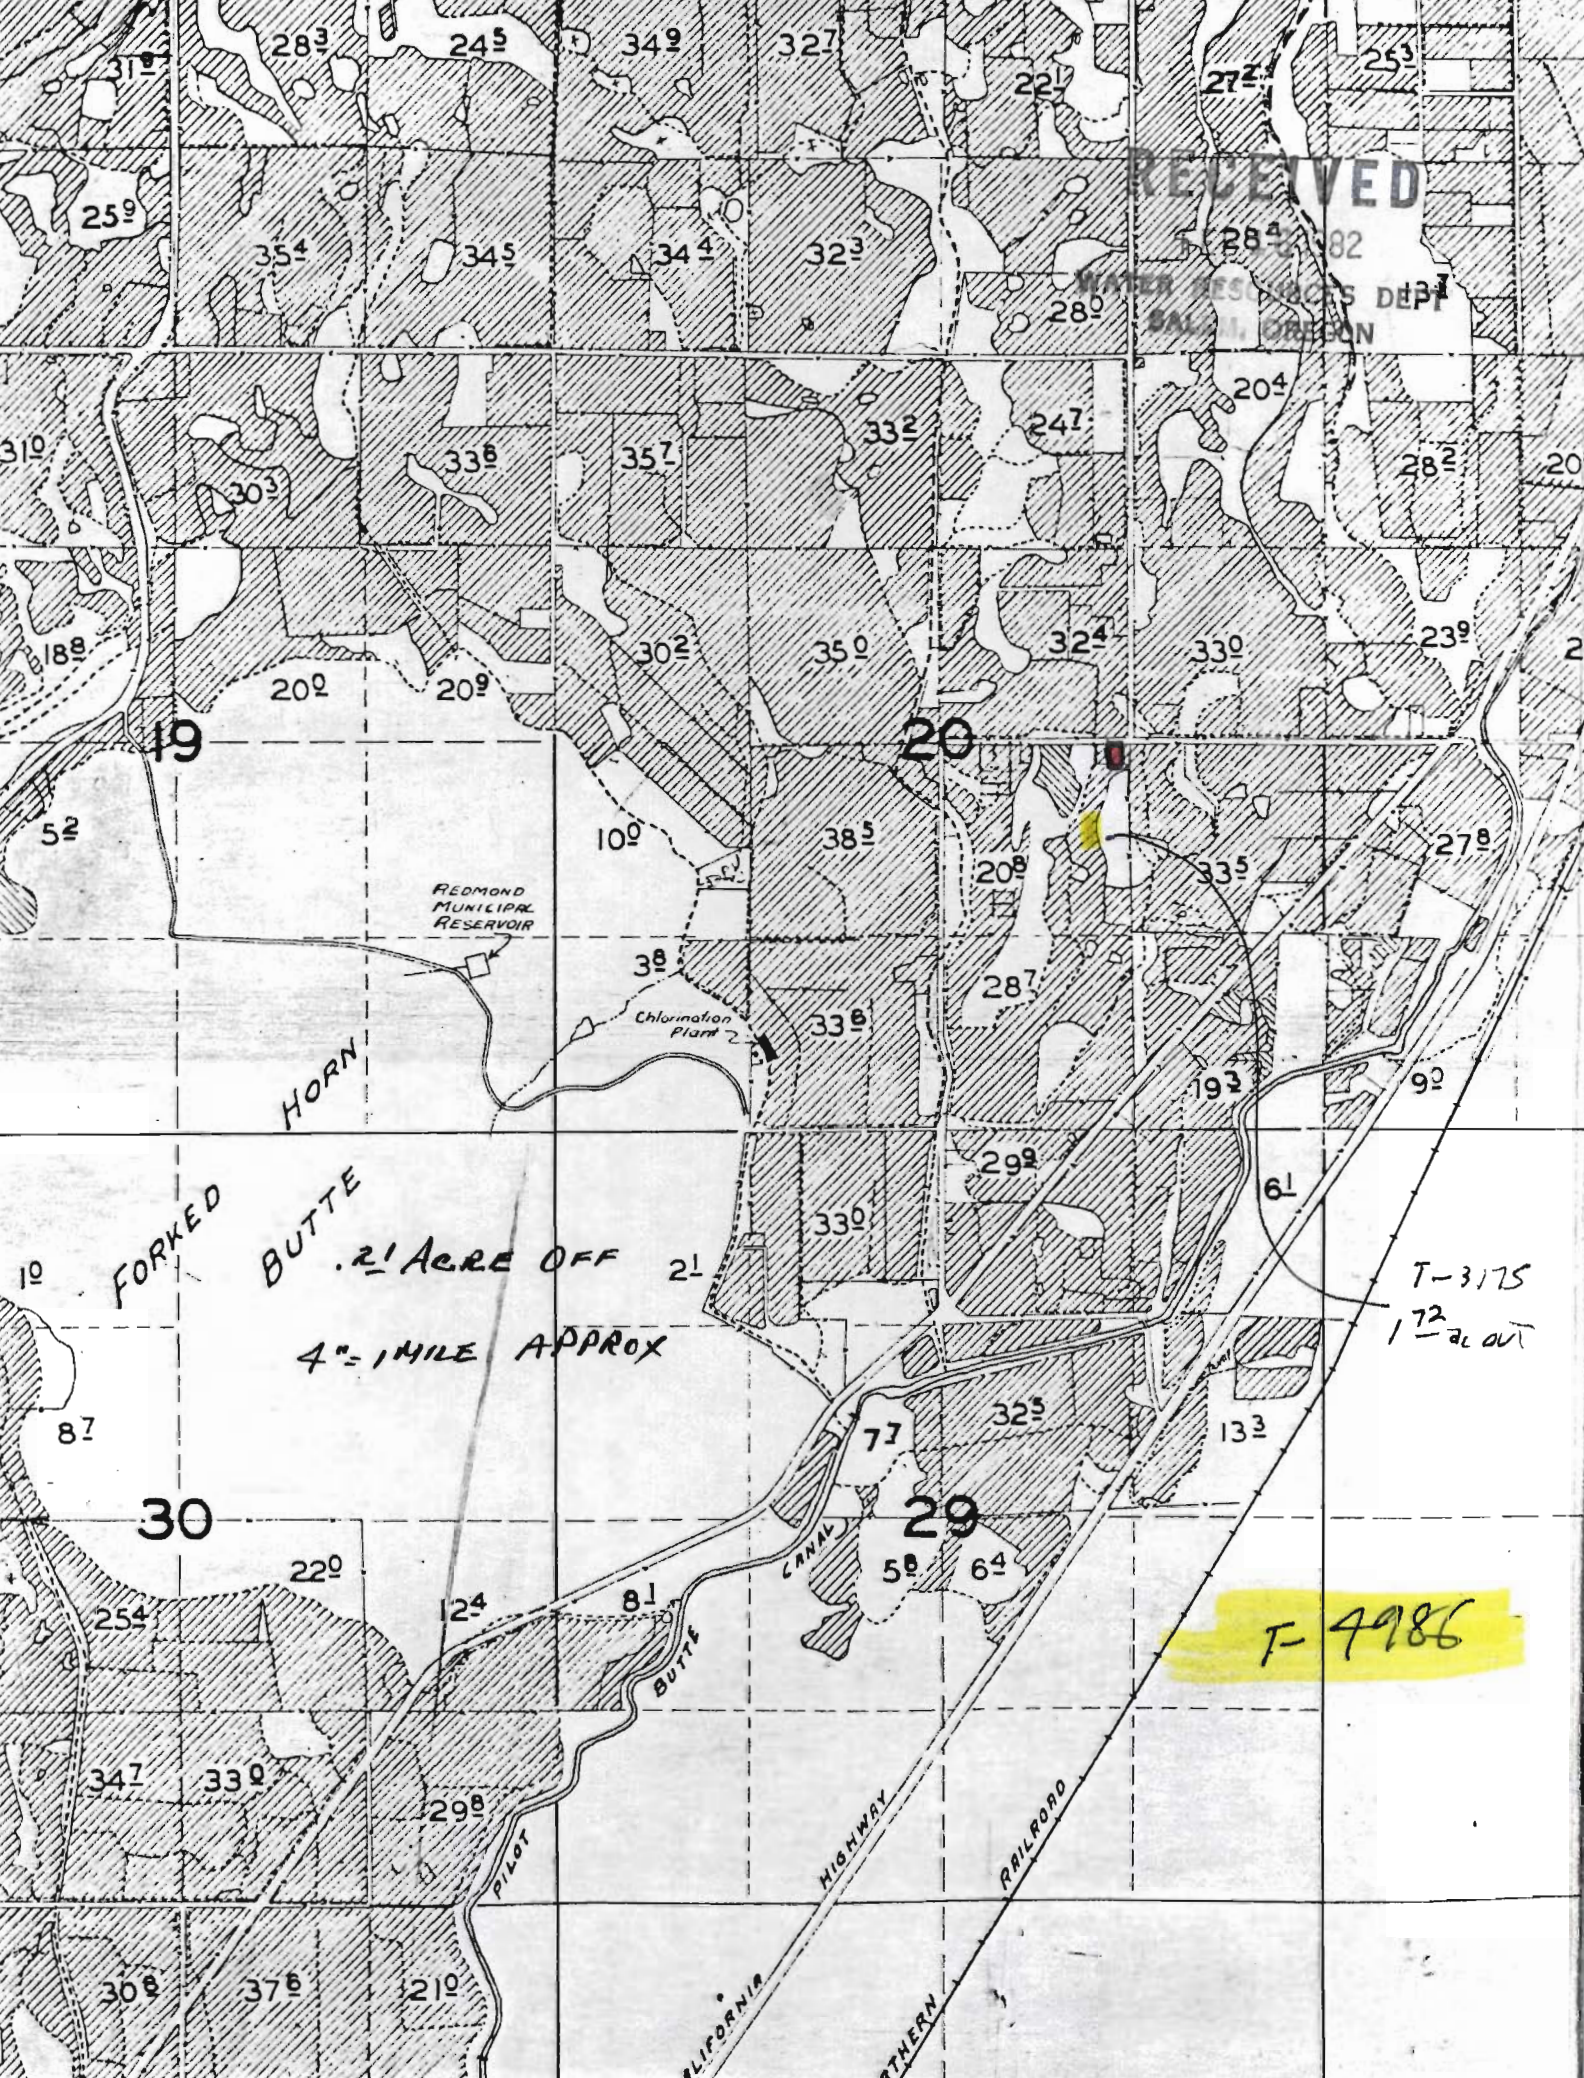

21 ACRE OFF
4" = 1 MILE APPROX

T-3175
172 ac OUT

T-4986