


T.4S., R.2E., W.M.

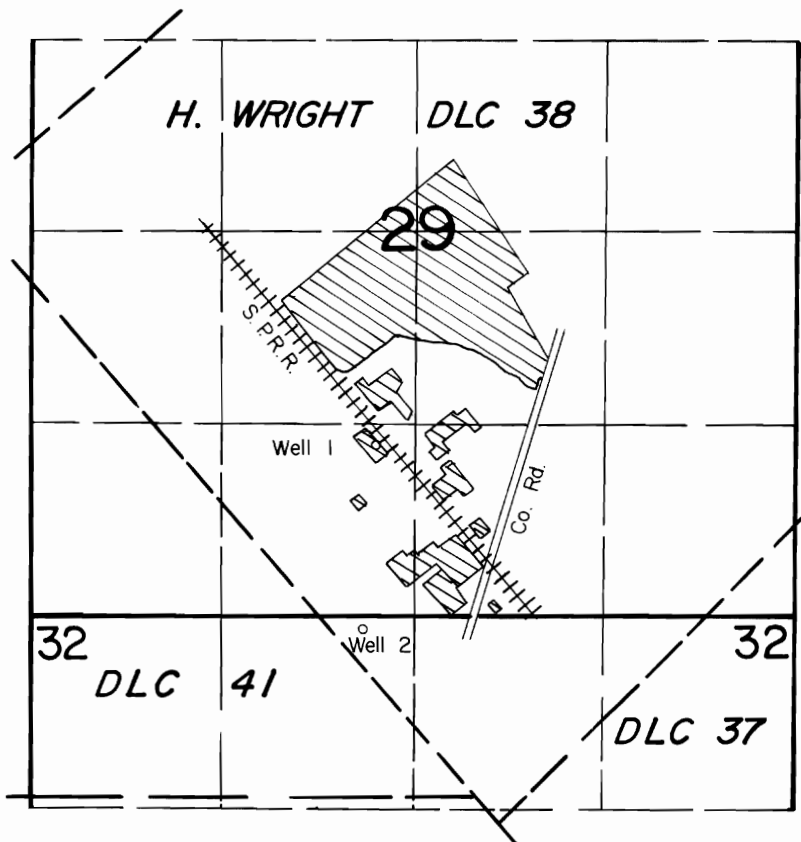

Well 1 Loc. : 1170' N. & 280' W.

Well 2 Loc. : 100' S. & 350' W., both from S. 1/4 Cor., Sec. 29.

Scale: 1" = 1320'

FINAL PROOF SURVEY UNDER

Transfer 4988

INDUSTRIAL USE = 

Application No. Permit No.
IN NAME OF

PUBLISHERS PAPER CO.

Surveyed JULY 9, 1986, by T. Warren