



T.16S., R.IIE., W.M.

SCALE : 1" = 1320'

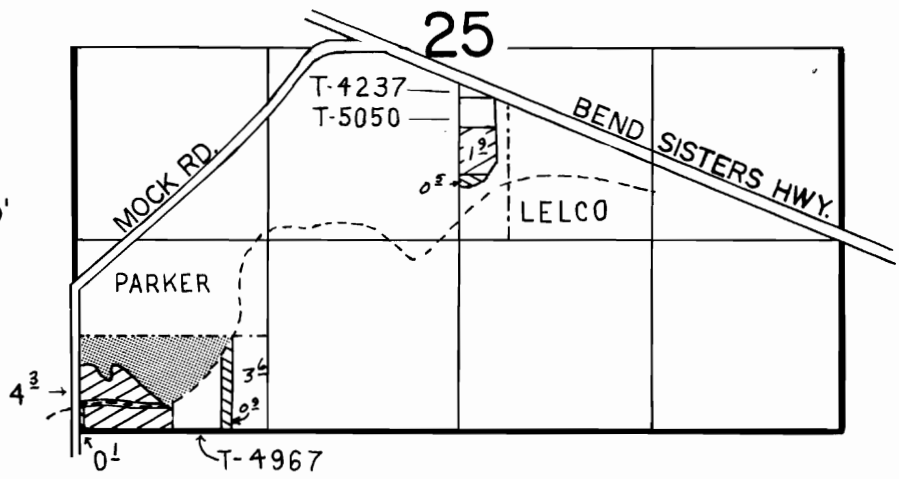


T.17S., R.IIE., W.M.

T.17S., R.IIE., W.M.


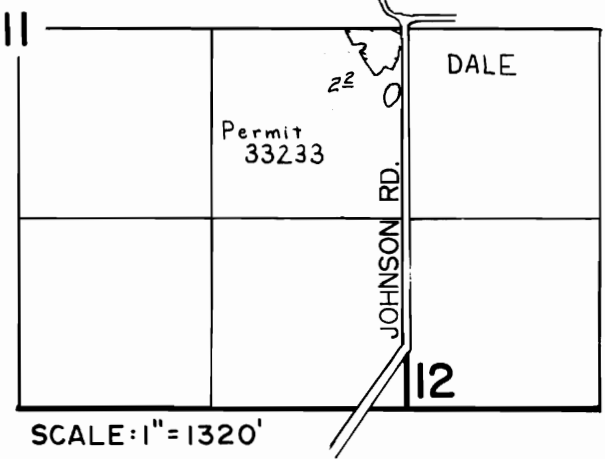




SCALE : 1" = 1320'

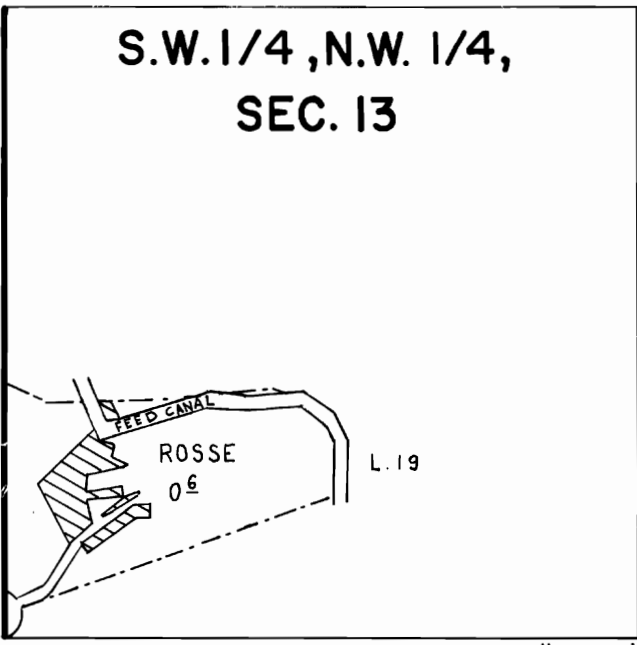S.W. 1/4, N.W. 1/4, SEC. 13

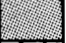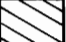

SCALE : 1" = 400'

-  C.-26508, ADJUDICATED
-  September, 1900
-  October 29, 1913
-  OVERACREAGE

FINAL PROOF SURVEY UNDER

TRANSFER NO. 4991

IN NAME OF

DALE, LELCO, PARKER, ROSSE

Surveyed OCT. 17... 1985., by LESLIE OLSON...