


T. 38 S., R. 8 W., W. M.

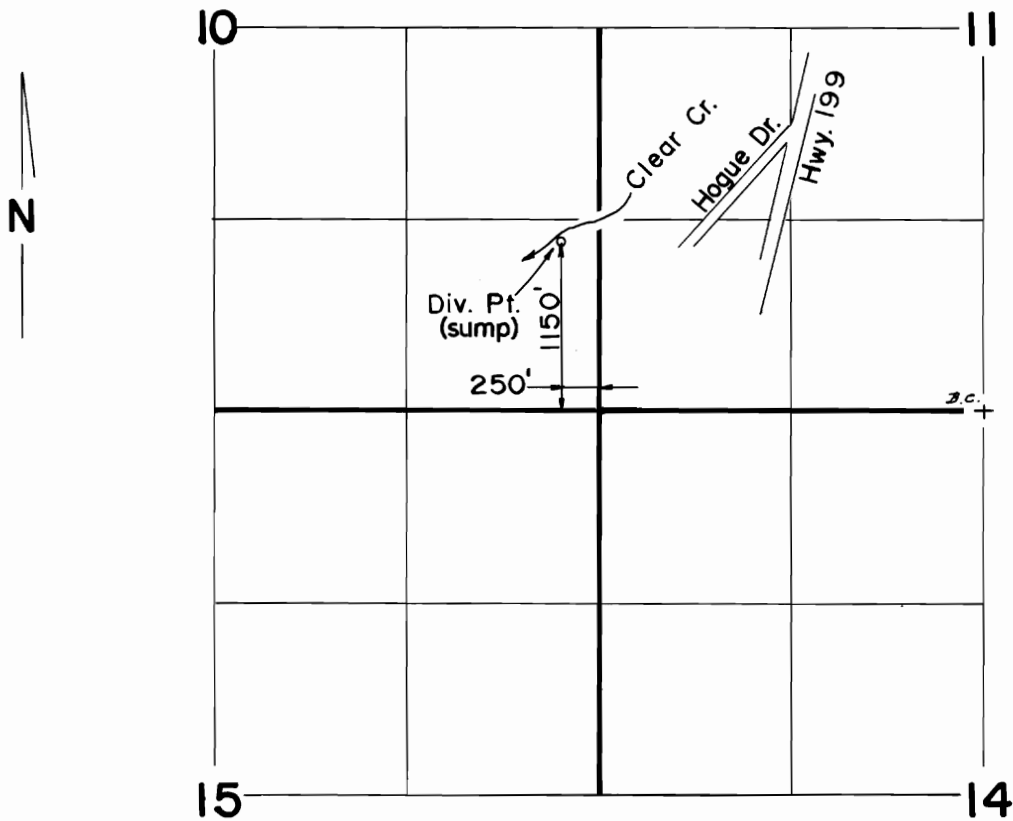

Scale: 1" = 1320'

FINAL PROOF SURVEY
UNDER

TRANSFER NO. 5000

Application No. Permit No.

IN NAME OF

..... DAVID J. HARTSVELDT

Surveyed JUN...9... 19.8.6, by B.....S...JAMES...