


T-5001

T-4243

T. 38S. R. 3W. W. M.

RECEIVED
MAR 5 1982
WATER RESOURCES DEPT
SALEM, OREGON

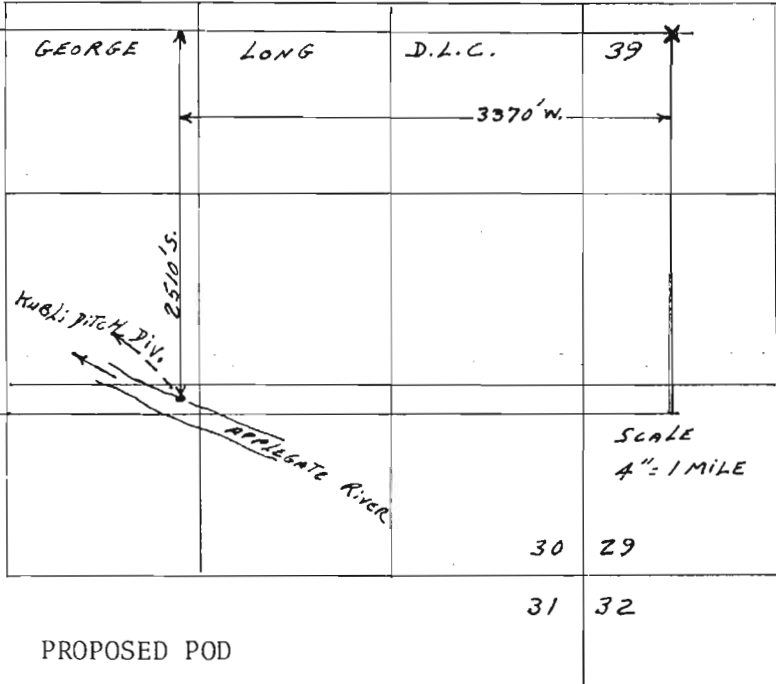

SCALE
4" = 1 MILE



MAP TO ACCOMPANY APPLICATION
OF BARBARA L. GRANT %
GENE KIMBALL FOR CHANGE IN
POINT OF DIVERSION

CERT. #
46562

CERT. #
46563

T. 38S R. 4W. W. M.

NECOR. DEC 38

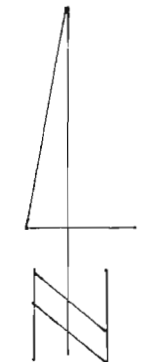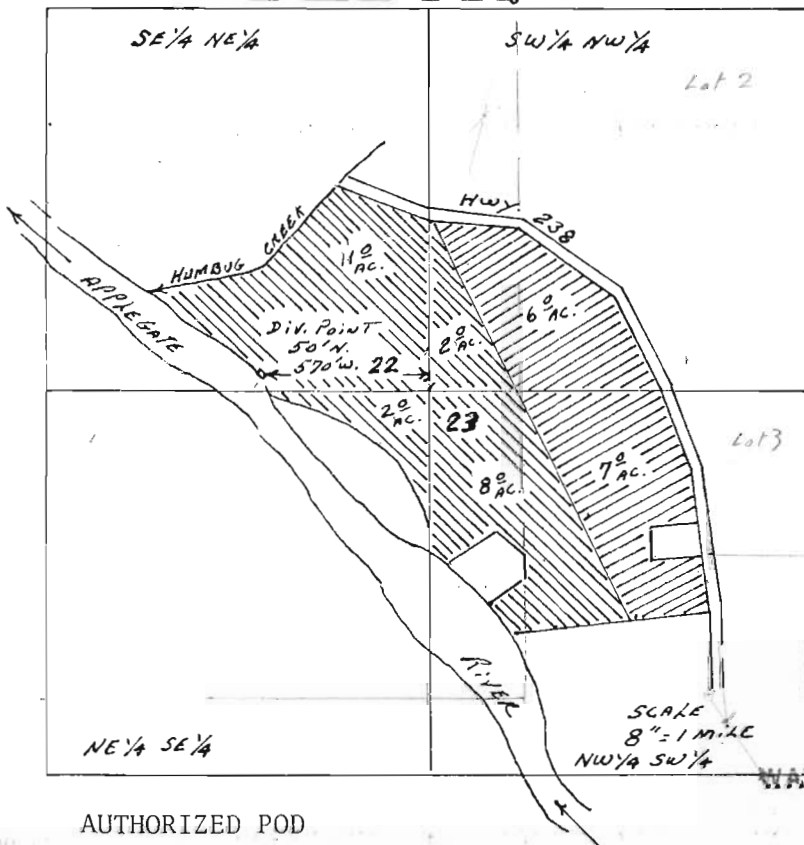

A-30-79

RECEIVED

JUN 26 1979

WATER RESOURCES DEPT
SALEM, OREGON

AUTHORIZED POD