


T. 30 S., R. 5 W., W.M.

SEC. 27

SE NW

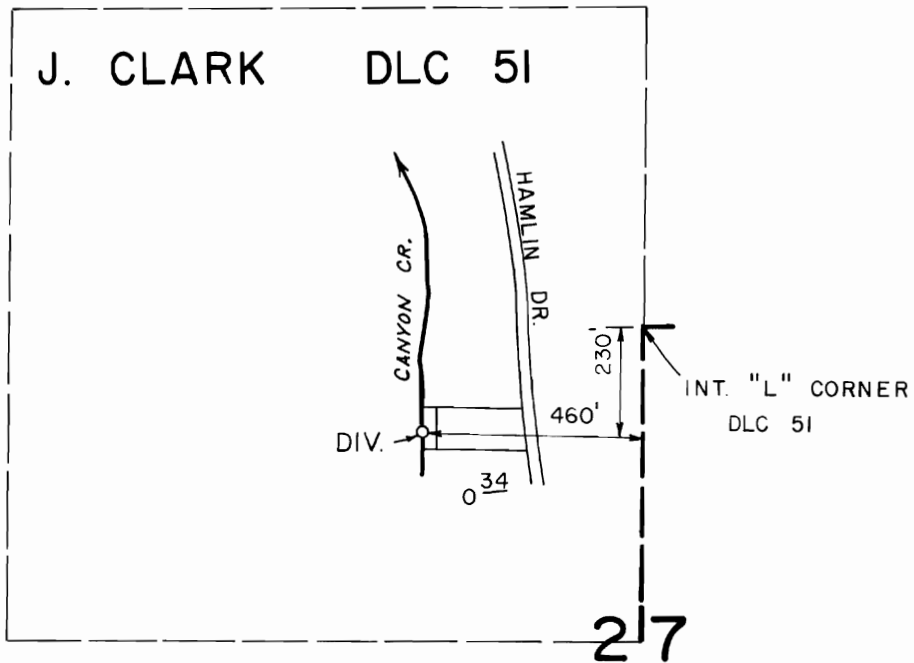

CANYON CREEK ESTATES - LOT 1

SCALE: 1" = 400'

**FINAL PROOF SURVEY**

UNDER

Application No. T-5002 Permit No. ....  
IN NAME OF

**EDWARD D. THOMPSON**

Surveyed JUNE 1, 1984, by *L.E. Cashner*.....