



8

9

10

T-5006

4" = 1 MILE APPROX.

RECEIVED

MAR 22 1982

WATER RESOURCES DEPT


TERREBONNE

17

16

15



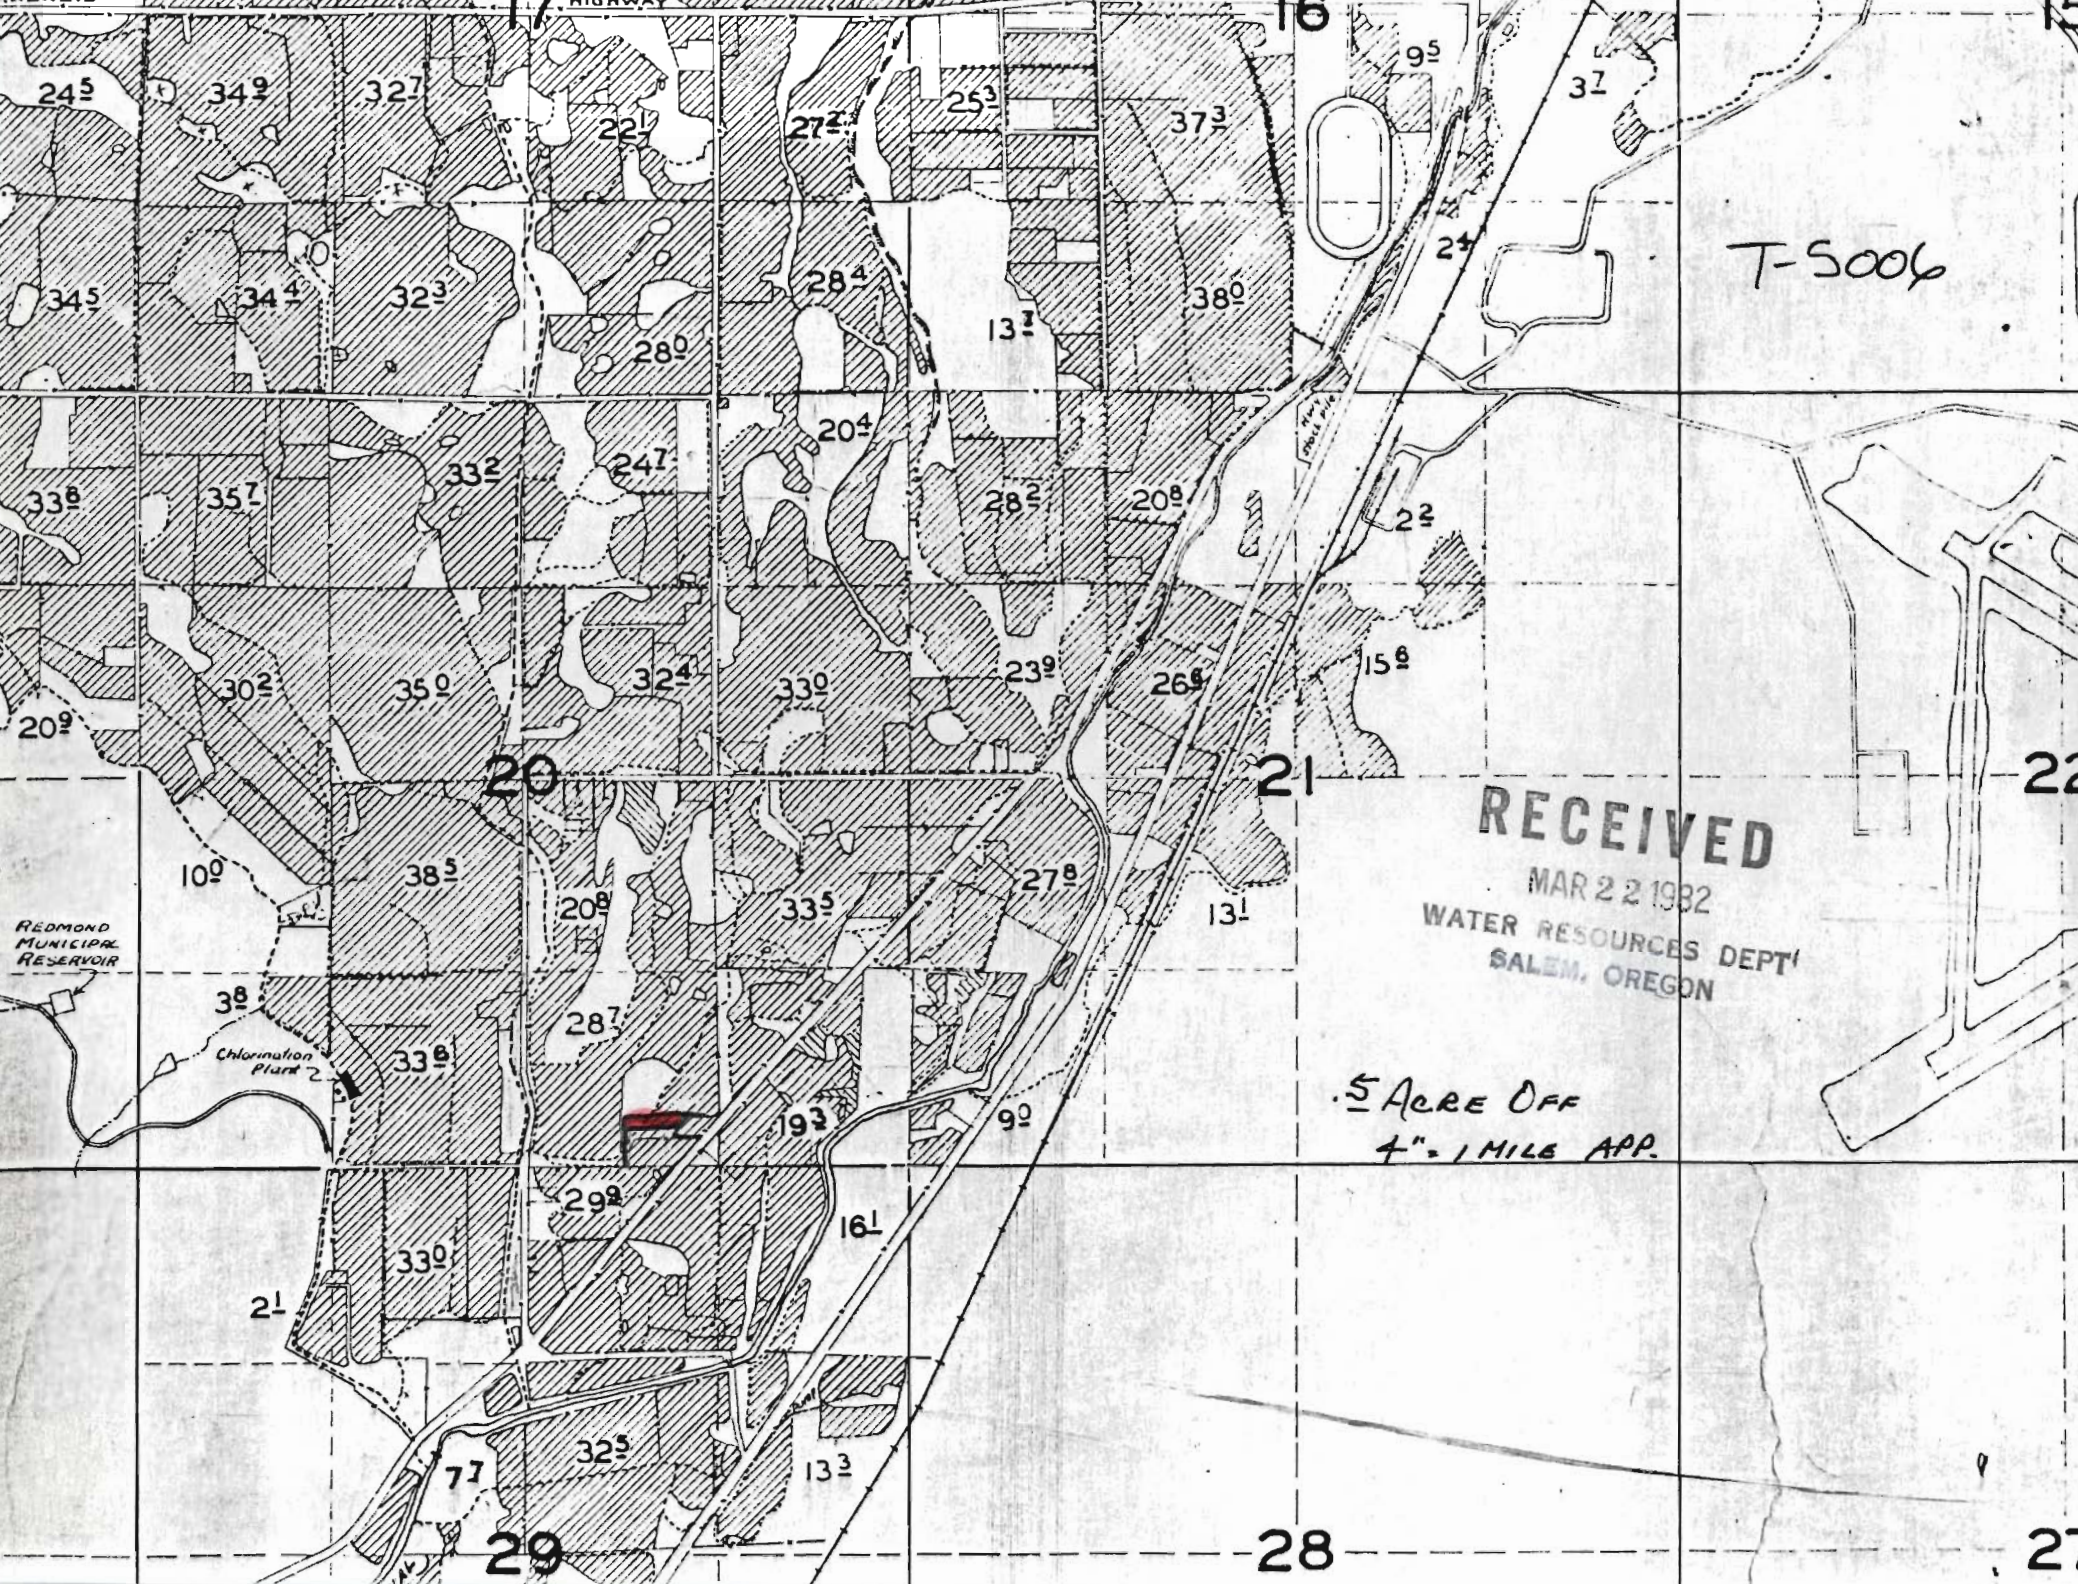

T-5006

RECEIVED
MAR 22 1982
WATER RESOURCES DEPT
SALEM, OREGON

5 ACRE OFF
4" = 1 MILE APP.

REDMOND MUNICIPAL
RESERVOIR

Chlorination
Plant 2