


T.1N., R.14E., W.M.

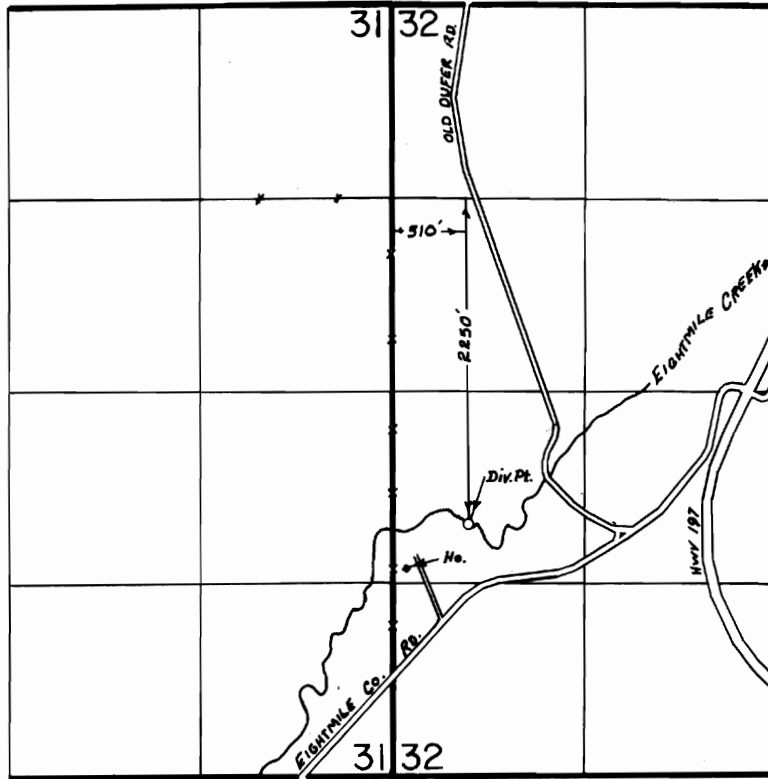

**FINAL PROOF SURVEY**  
UNDER

Transfer No. 5012  
Application No. .... Permit No. ....  
IN NAME OF

..... PEGGY A. GERKING .....

Surveyed Oct. 11, 1982, by T. J. Paul .....