


REDMOND

1.2 ABRE OFF
4.1 MILE APPROX

RECEIVED
APR 16 1982
WATER RESOURCES DEPT
SALEM, OREGON

T-5014

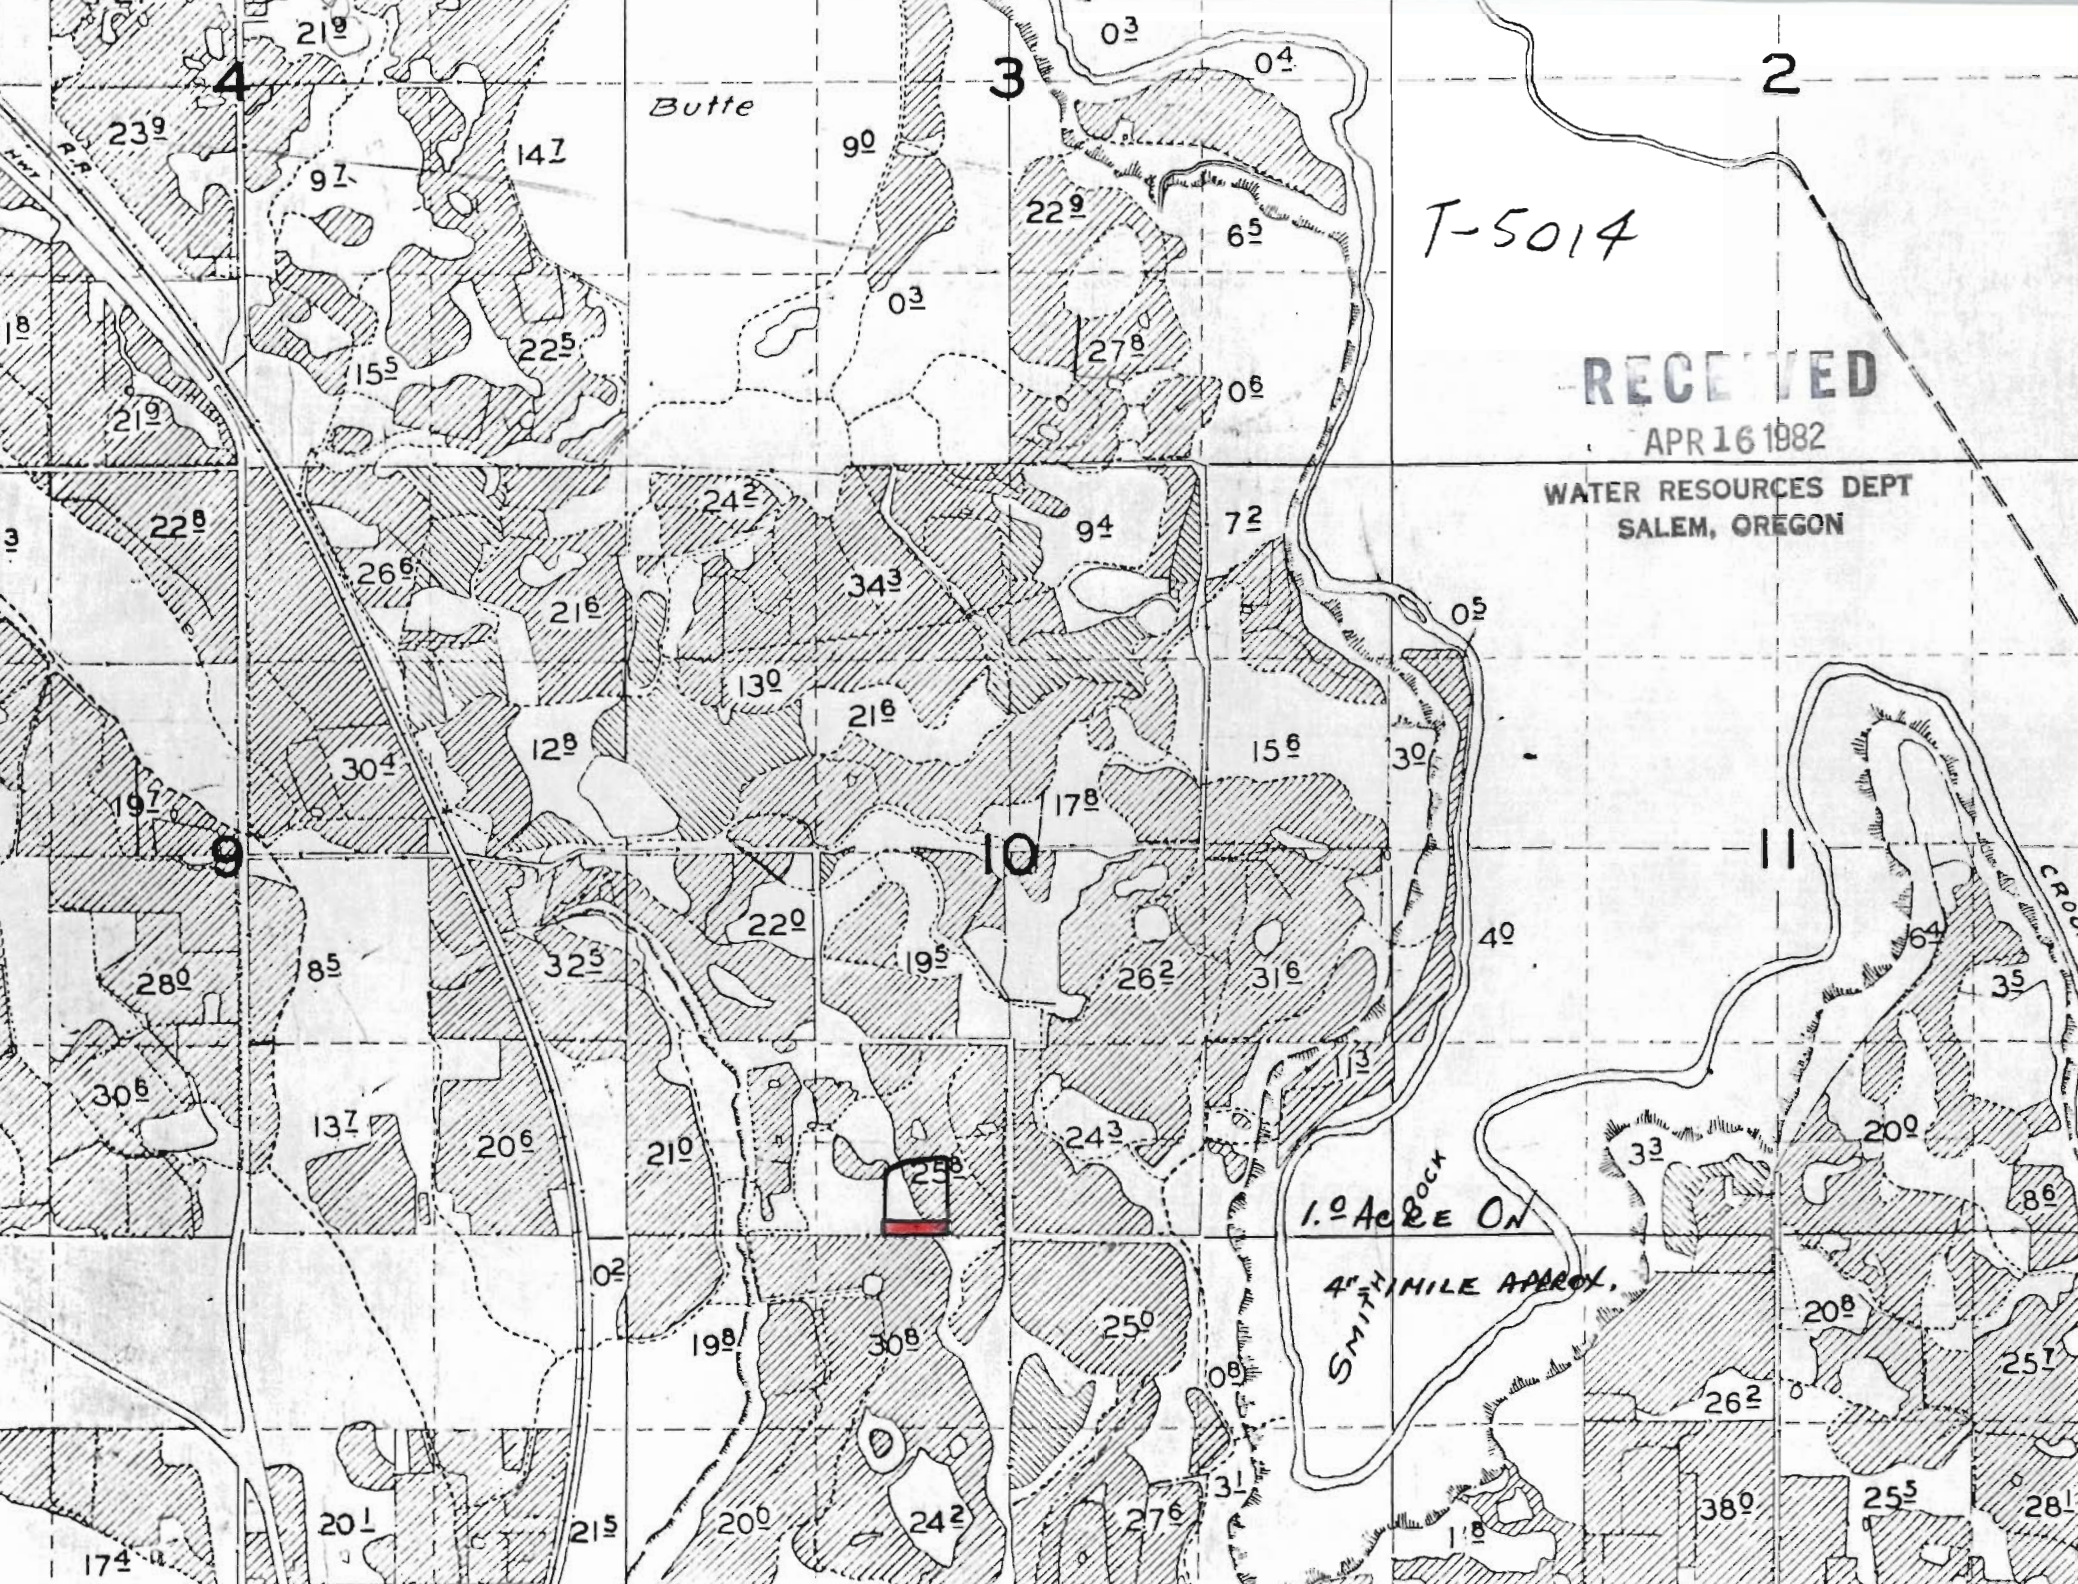

Butte

T-5014

RECEIVED

APR 16 1982

WATER RESOURCES DEPT
SALEM, OREGON

1.0 ACRE ON

SMITH ROCK
4¹/₂ MILE APPROX.