

16-11-24

.4 ON (31410)

1.0 ON (26508)


2.0 OFF (31410)

3 OFF (31410)

6 OFF (31410)

1.0 OFF (26508)

.5 ON (31410)

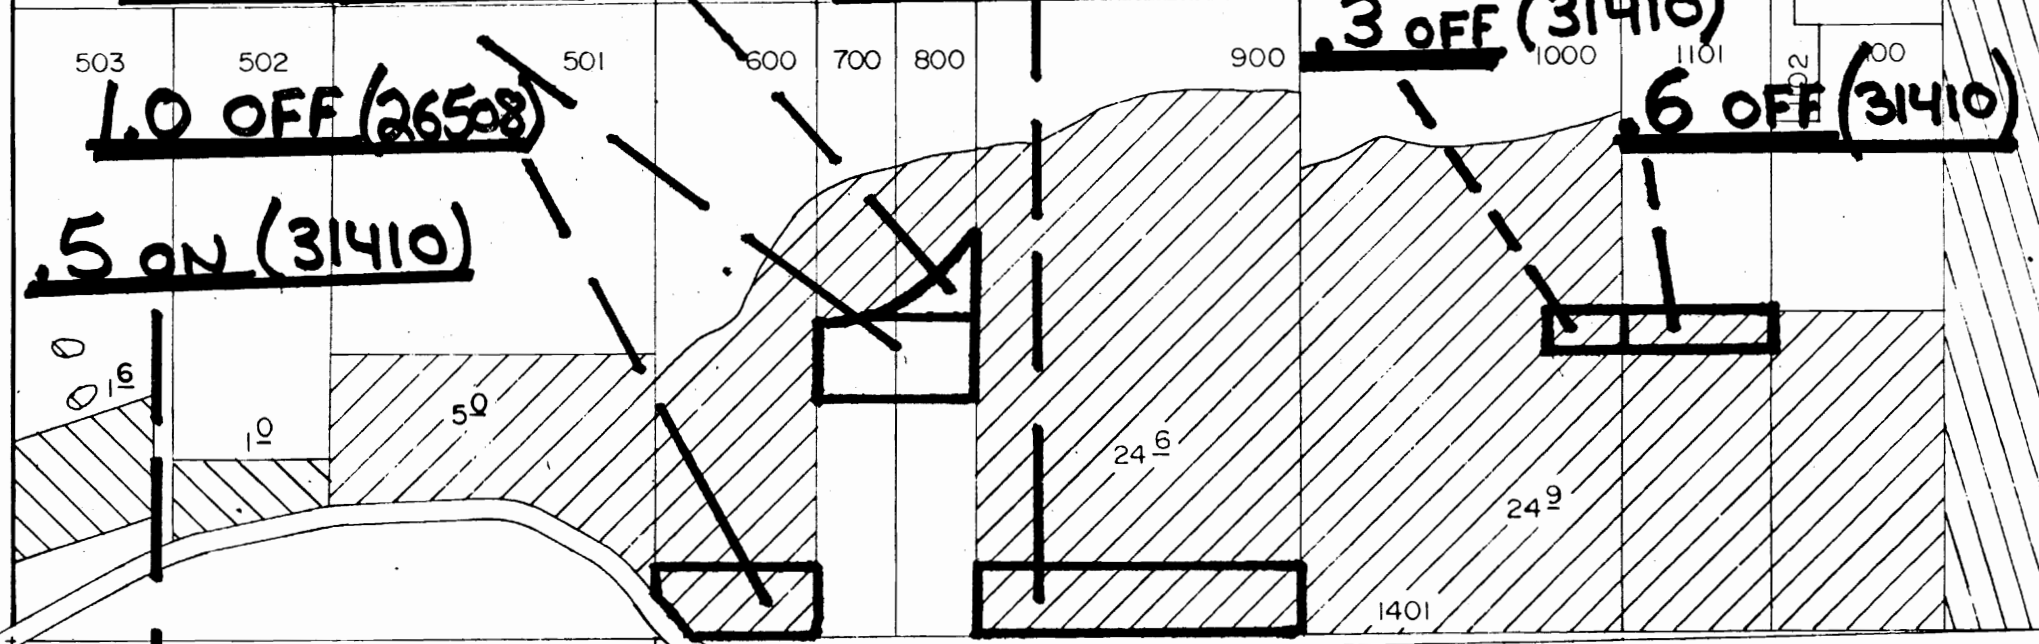

RECORDED
APR 13 1952

WATER RESOURCES DEPT
SALEM, OREGON