


From:

4N R24E Wm Sec 13

T-5067

SE 1/4 NE 1/4

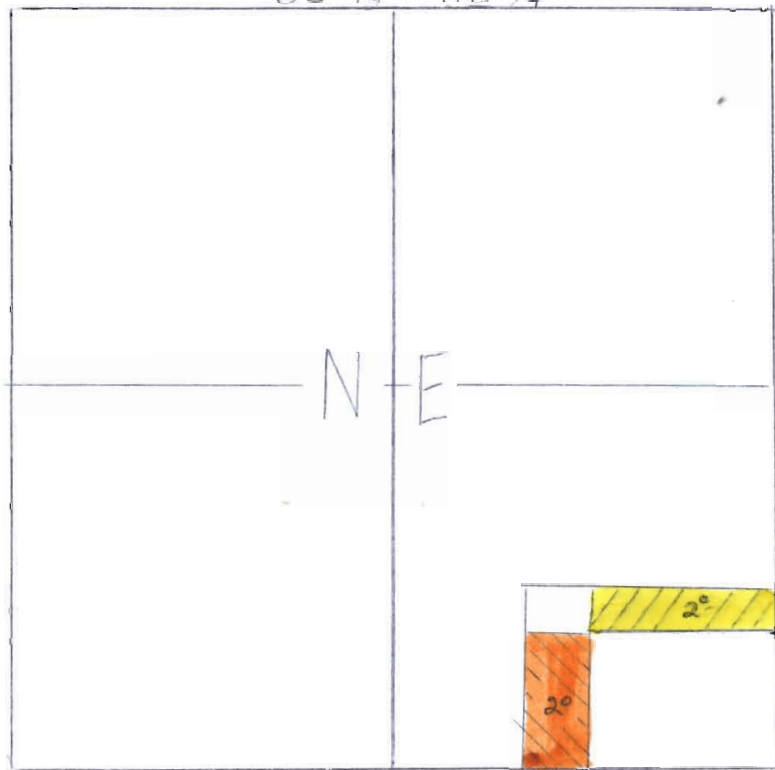

To:

4N R 24 E W m Sec 13

SE 1/4 NE 1/4

RECEIVED

JUN 7 1982

**WATER RESOURCES DEPT
SALEM, OREGON**