


T.6S., R.1E., W.M.

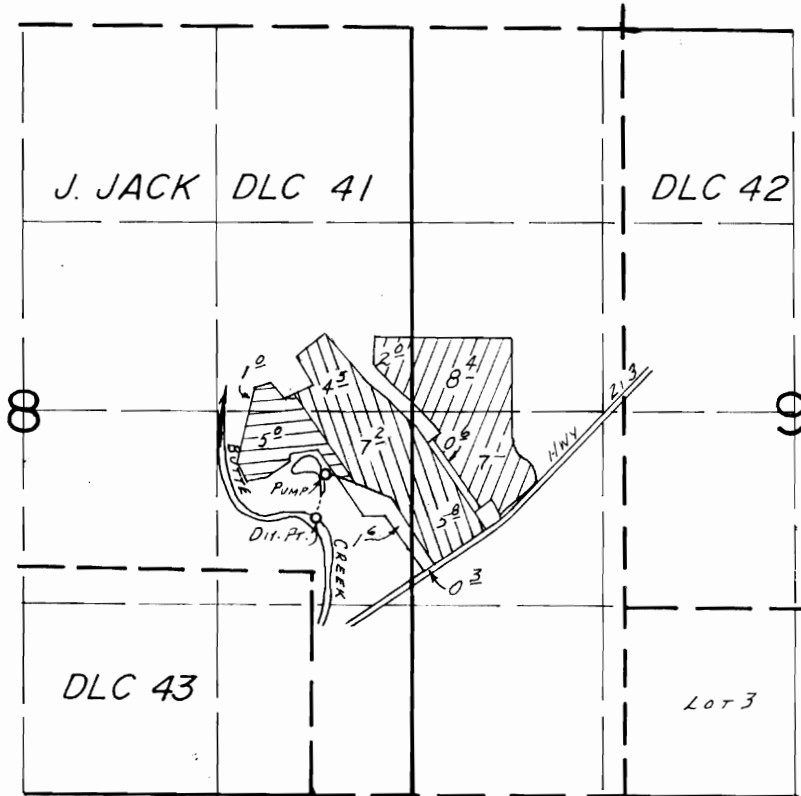

DIV. PT. LOC.: 3390 S. & 2100 W. FROM NE COR. J. JACK DLC 41

SCALE: 1" = 1320'

FINAL PROOF SURVEY

UNDER

Transfer No. 5069

Transfer No. 5504

Cert. 17290 (not involved)

IN NAME OF

WILBUR & DARLINE VANDERBECK

Surveyed July 23... 1984, by B.W. BISHOP.....
June 14 1985 T.M. WARREN

BWB