




T. 39 S., R. 11 E., W.M.

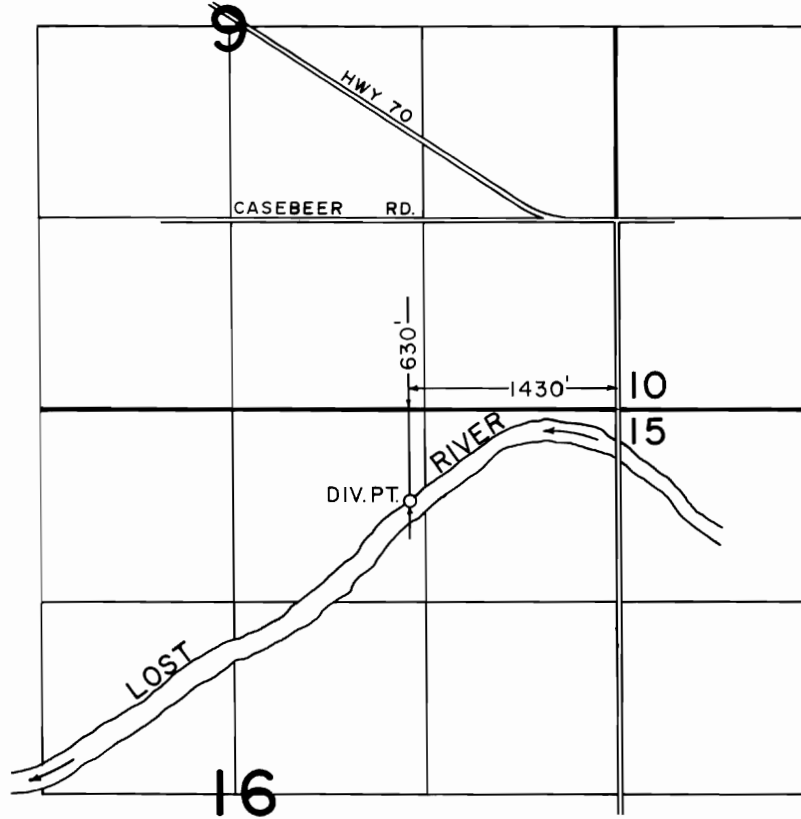

SCALE: 1" = 1320'

FINAL PROOF SURVEY
UNDER

TRANSFER NO. 5073

Application No. Permit No.
IN NAME OF

STEVEN W. CASEBEER

Surveyed SEPT. 12, 1989, by B. W. BISHOP