


# T.17S., R.13E., W.M.

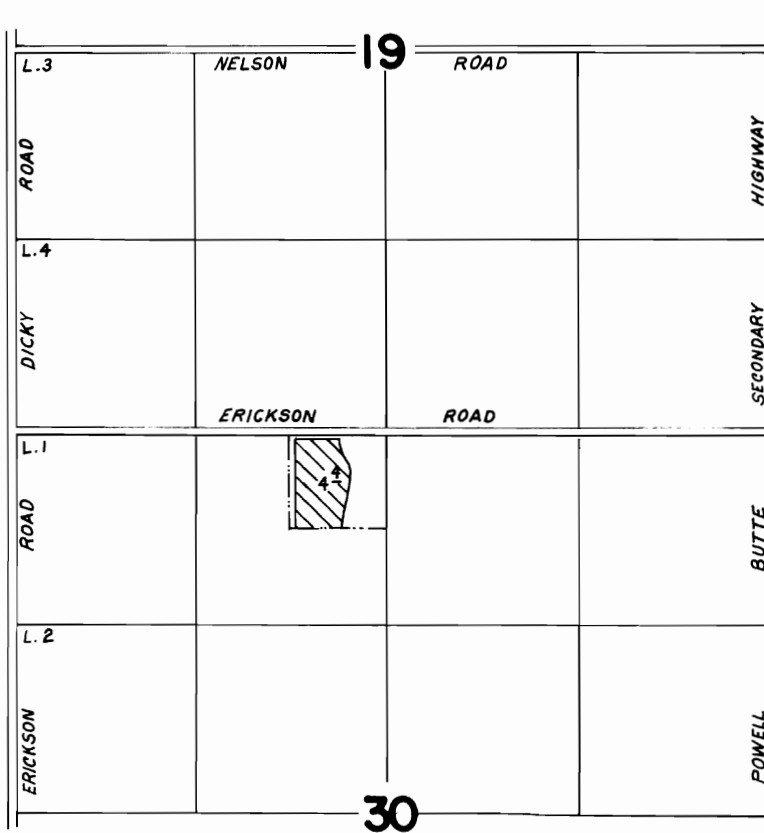

SCALE: 1" = 1320'

## FINAL PROOF SURVEY UNDER

TRANSFER NO. 5077  
Application No. .... Permit No. ....  
IN NAME OF

..... JAMES TSOURMAS / CO.I.D. ....

Surveyed JUNE 28, 1984, by LESLIE OLSON..