


T.16 S., R.11 E., W.M.

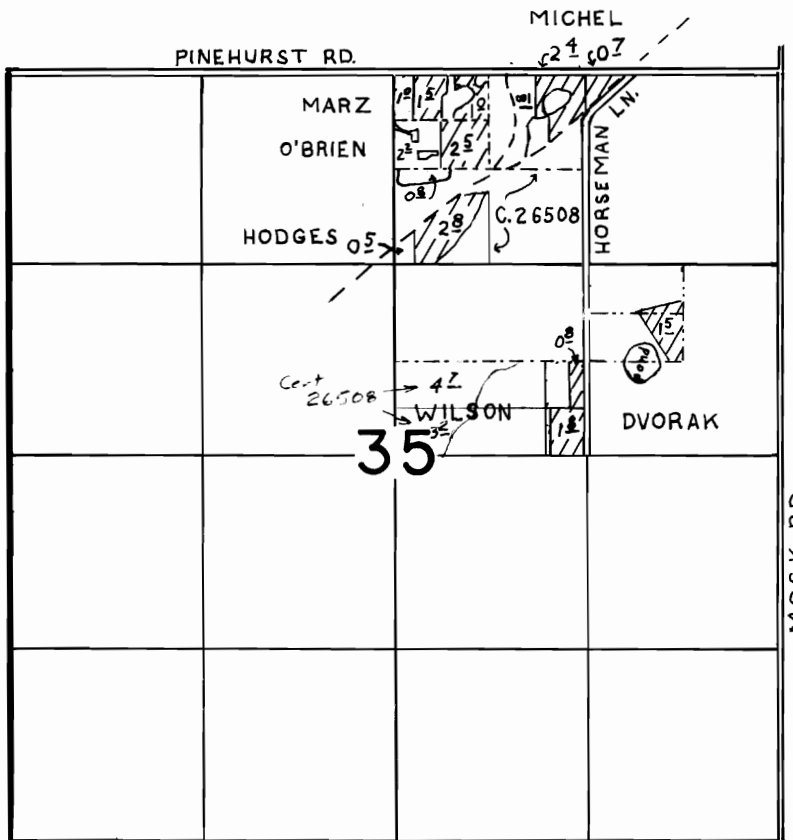

FINAL PROOF SURVEY

UNDER

TRANSFER NO. 5087

IN NAME OF

DVORAK, HODGES, MARZ, O'BRIEN, MICHEL, WILSON

Surveyed MAY 10 1985, by LESLIE OLSON.