

REDMOND

BUTTE  
PILOT  
CANAL

MILL  
POND


T-5094

2.0 ACRES OFF  
4" ± 1 MILE APPROX.

**RECEIVED**  
JUL 23 1982  
WATER RESOURCES DEPT.  
SALEM, OREGON

ROBER



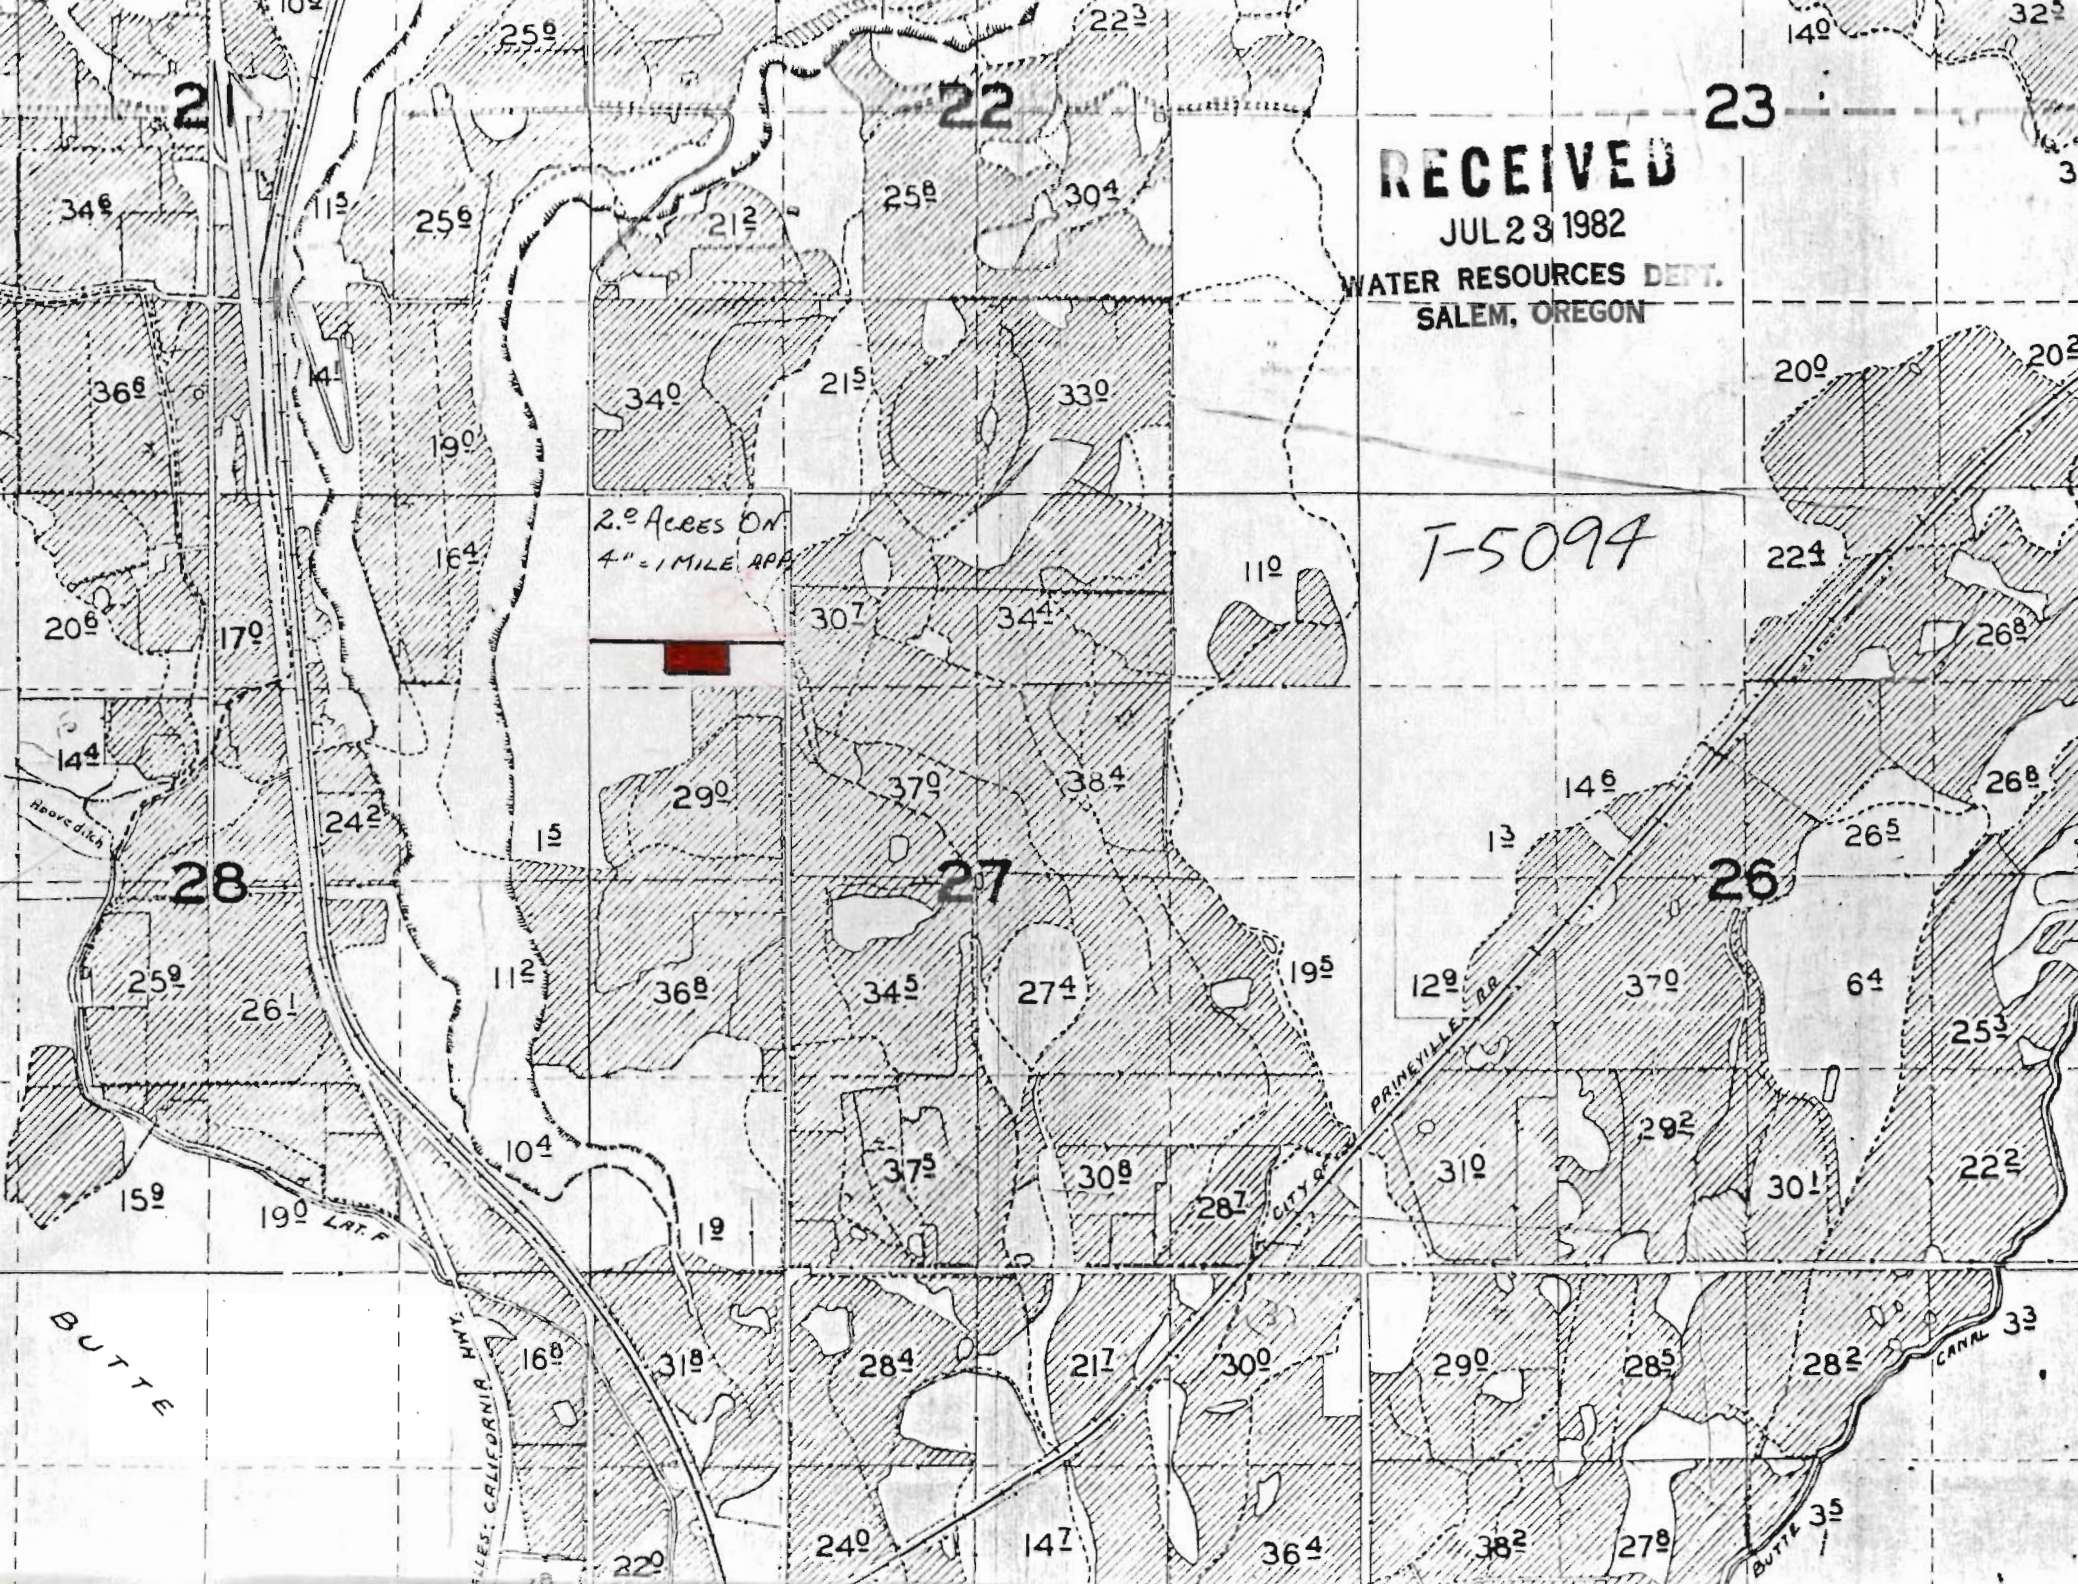

RECEIVED

JUL 23 1982

WATER RESOURCES DEPT.  
SALEM, OREGON

I-5094

2.0 Acres ON  
4" = 1 MILE APP



BUTTE

ILES: CALIFORNIA HWY

PRINEVILLE RR

CANAL 33

BUTTE 35