

RECEIVED

AUG 20 1982

WATER RESOURCES DEPT.  
SALEM, OREGON

21

22

T-5103

ALFALFA

HIGHWAY


12.0 ACRES OFF


28


27

9 BEND - ALFALFA

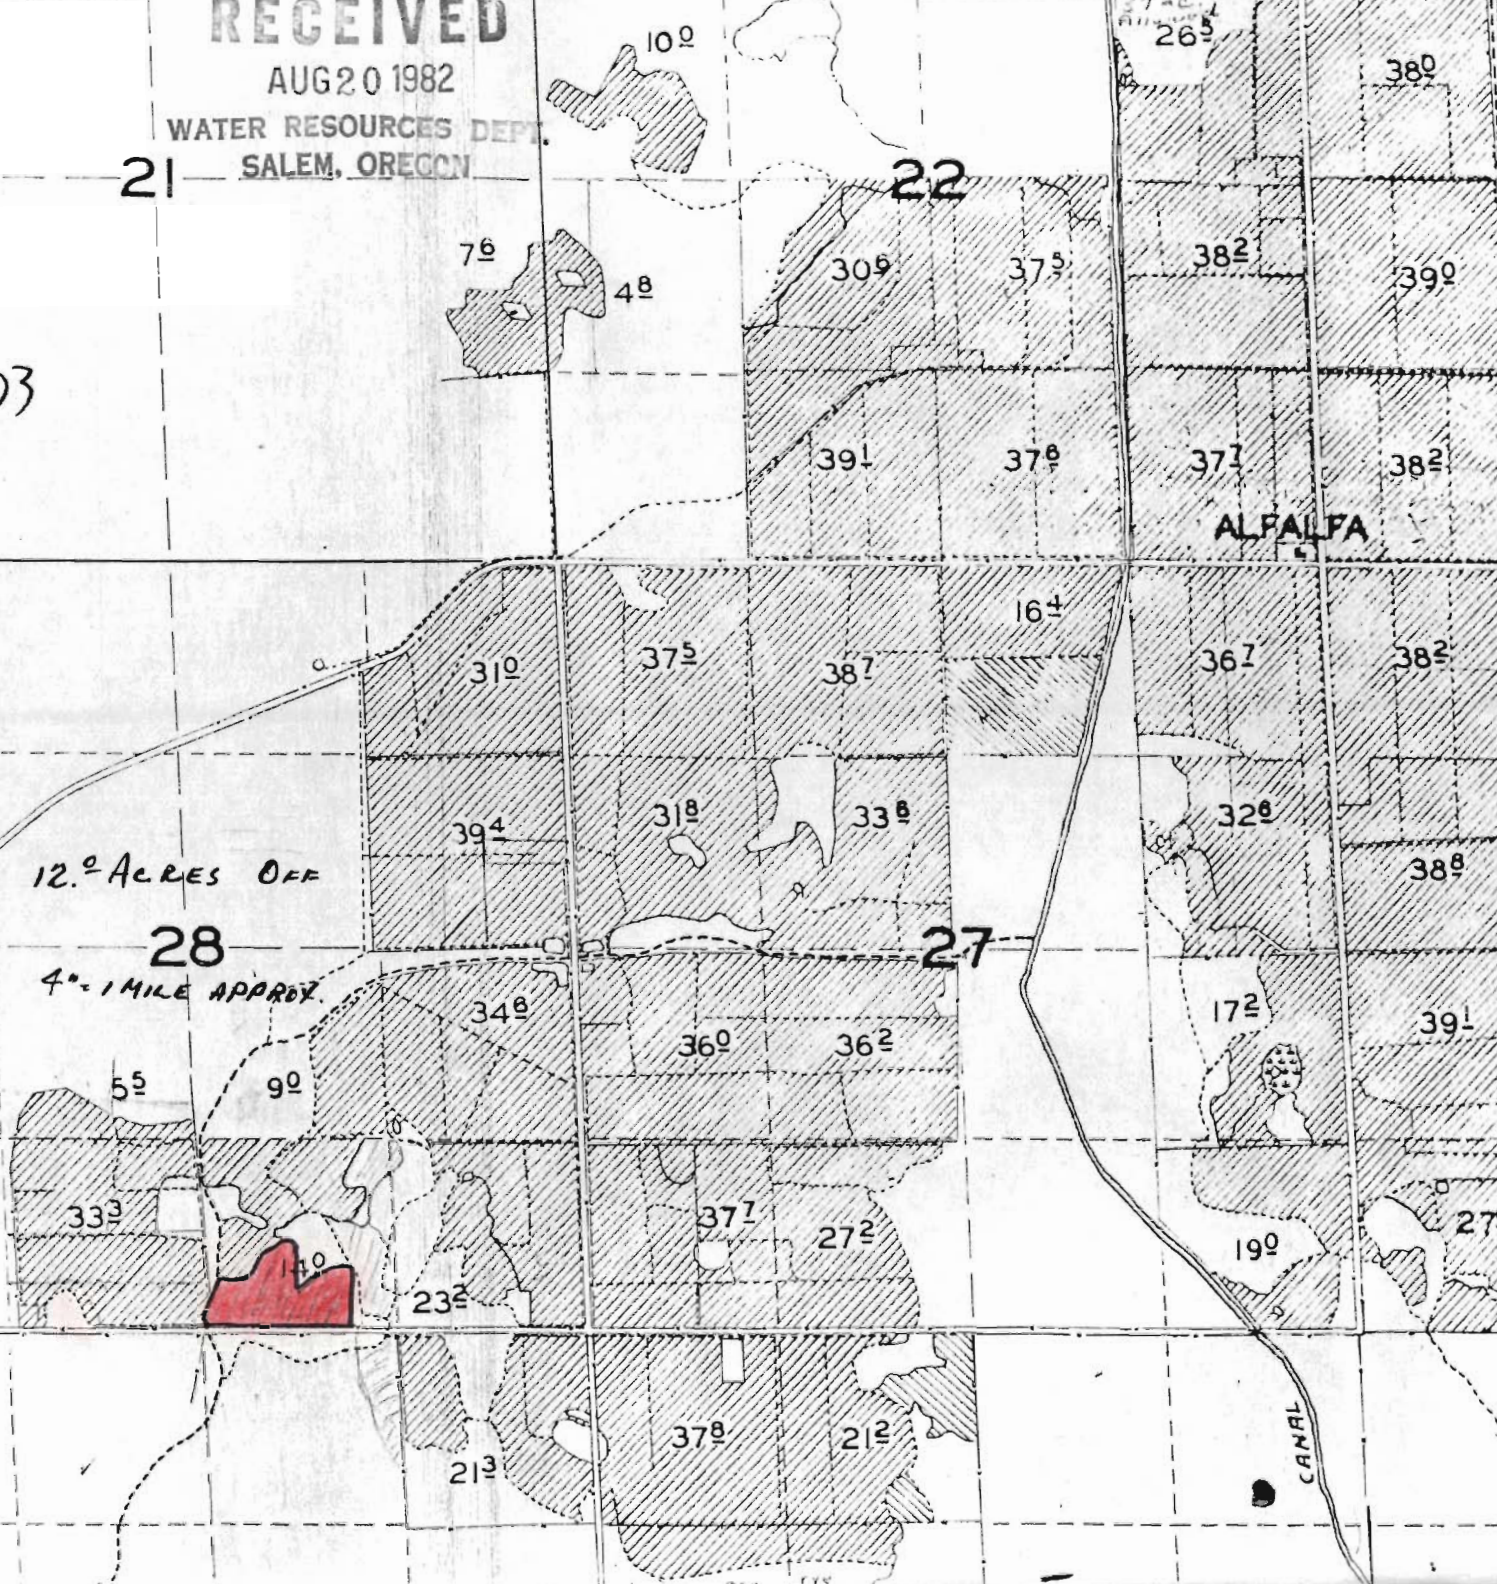

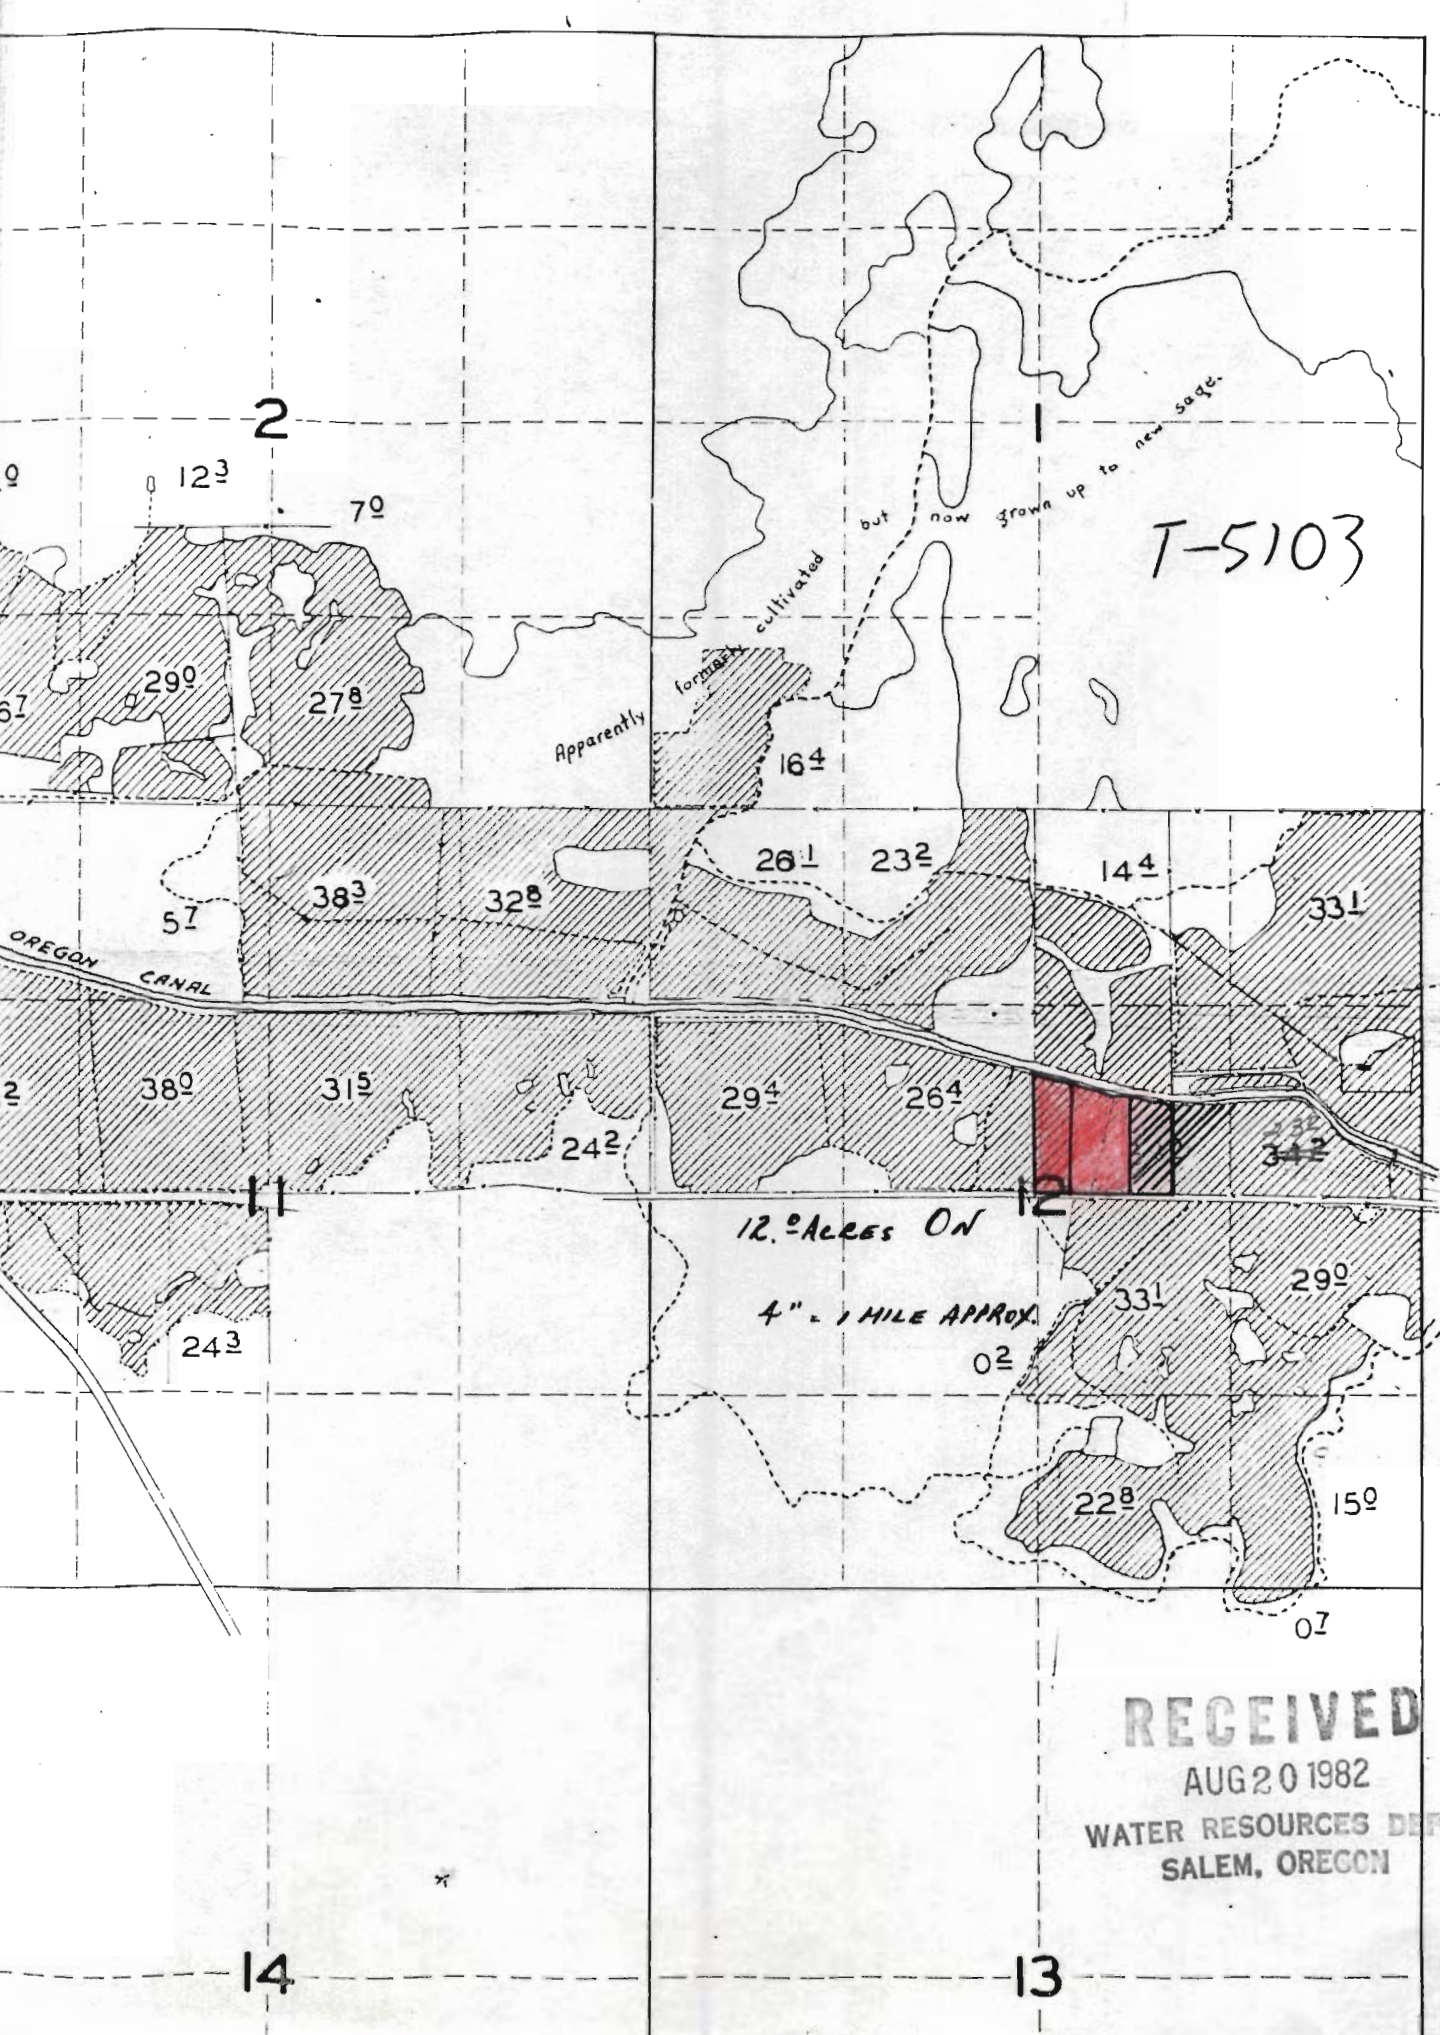

T-5103

Apparently  
formerly cultivated  
but now grown up to new sage.

12.0 ACRES ON 12

4" = 1 MILE APPROX.

RECEIVED

AUG 20 1982

WATER RESOURCES DEPT  
SALEM, OREGON

14

13