


T.15S.R.15E.W.M.

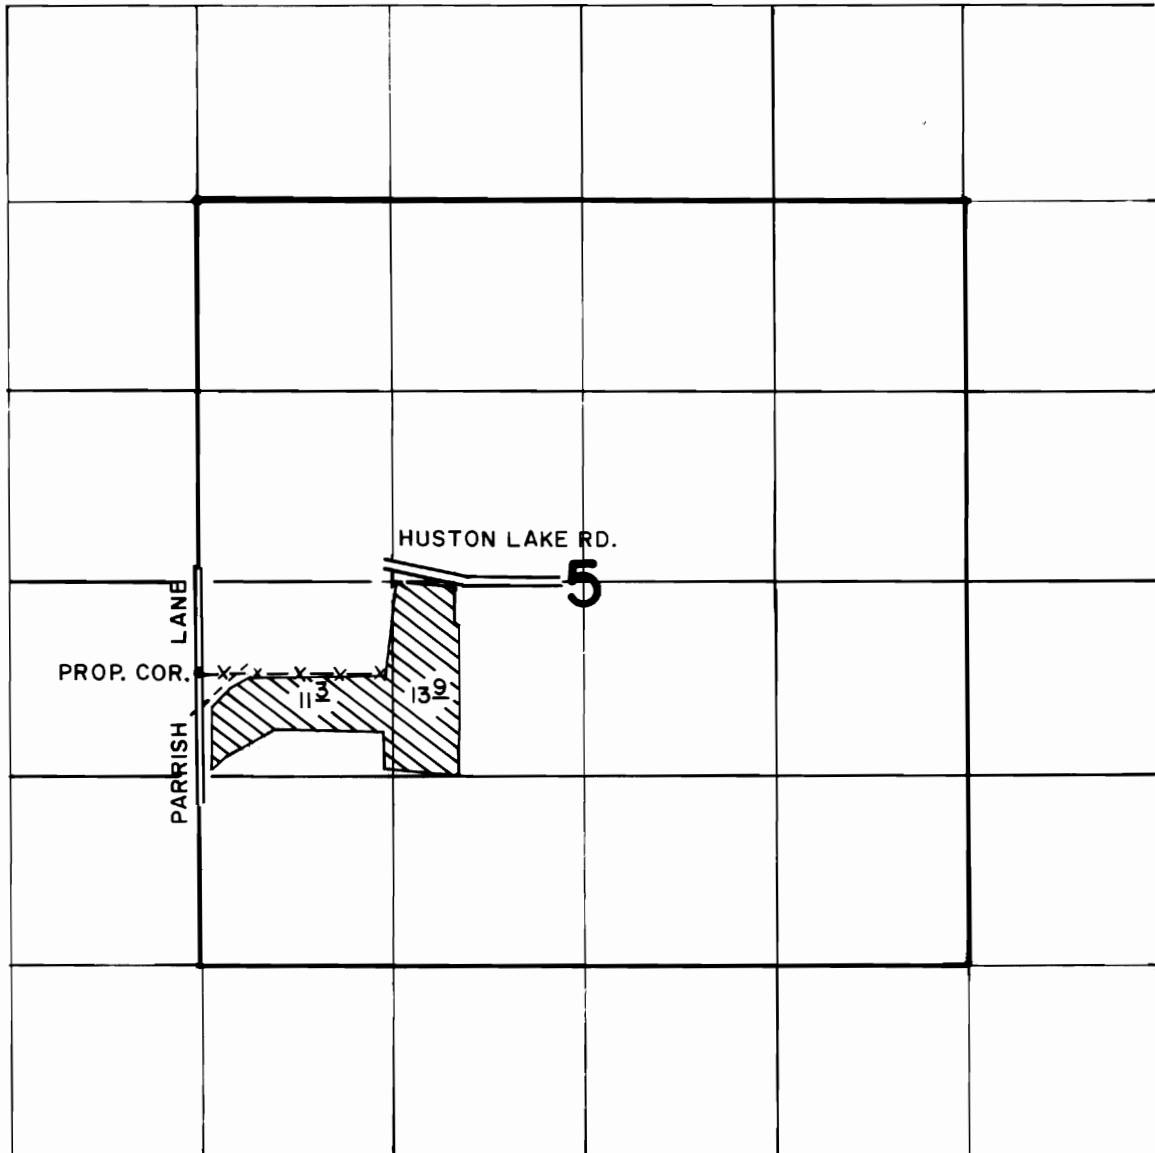

FINAL PROOF SURVEY

UNDER

Tr. 5105

Application No. Permit No.

IN NAME OF

.....BROOKS RESOURCES CORP.....

Surveyed NOV. 7, 1983, by D. PANTHER.....