


# T.14S., R.14E., W.M.

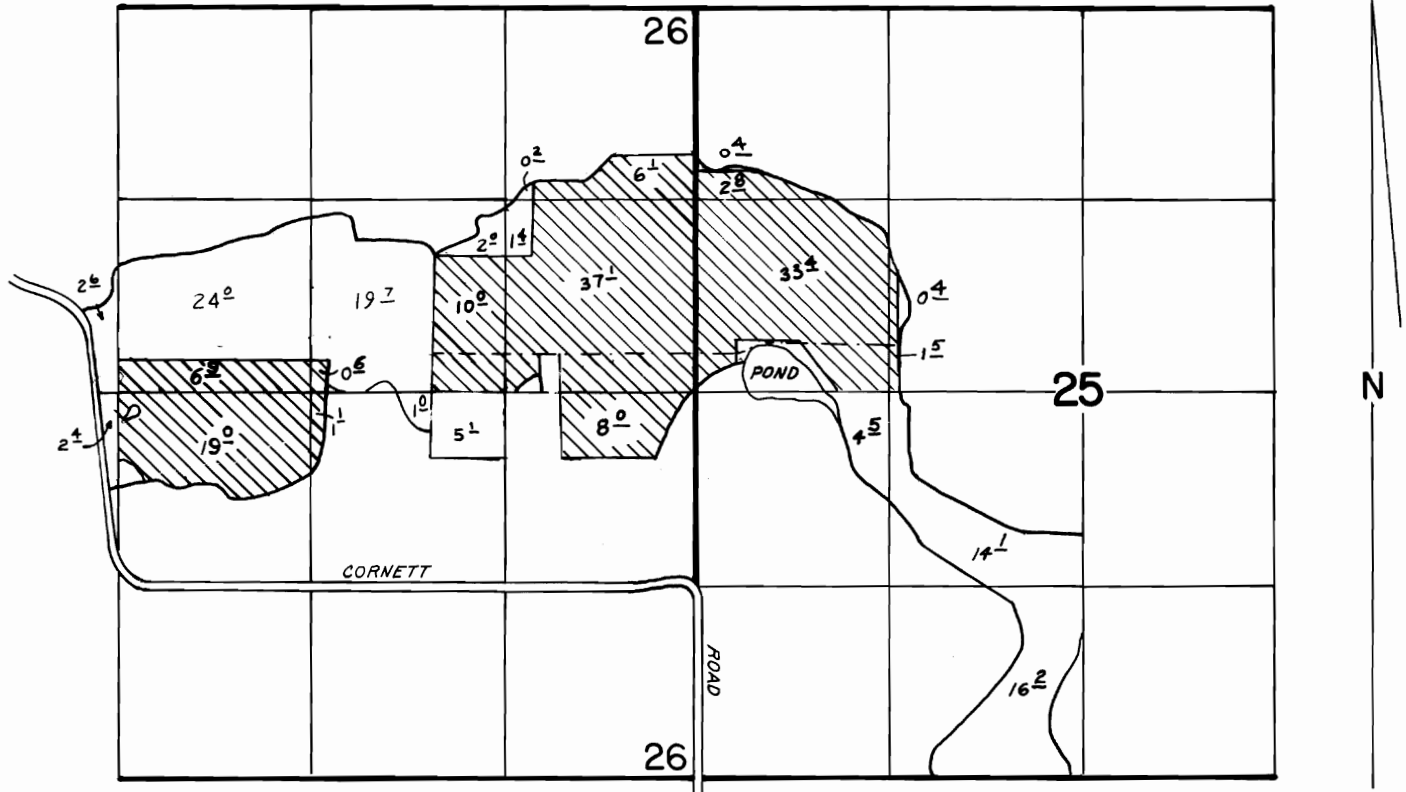

SCALE: 1" = 1320'

## FINAL PROOF SURVEY UNDER

TRANSFER NO. 5106

IN NAME OF

LARK RANCHES

Surveyed MAY 30, 1985, by LESLIE OLSON.