


T.38S., R.4W., W.M.

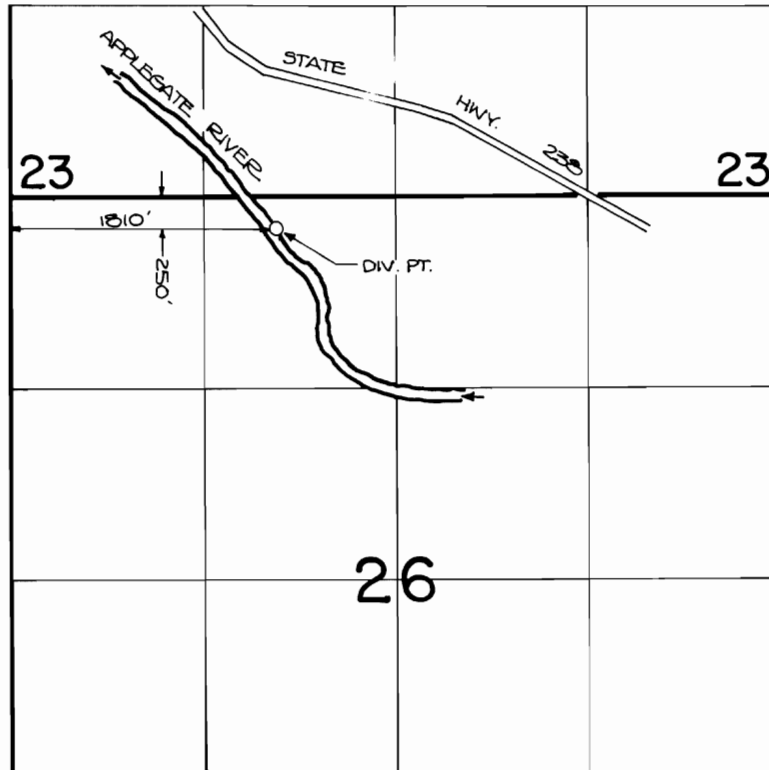

FINAL PROOF SURVEY UNDER

TRANSFER NO. 5113

IN NAME OF

LAWRENCE E. & NORMA G. HOYT

Surveyed JULY 14 1983, by B. JAMES