


SECTION 21 T.16S. R.12E.W.M.
 DESCHUTES COUNTY

1" = 400'

See Map 16 12

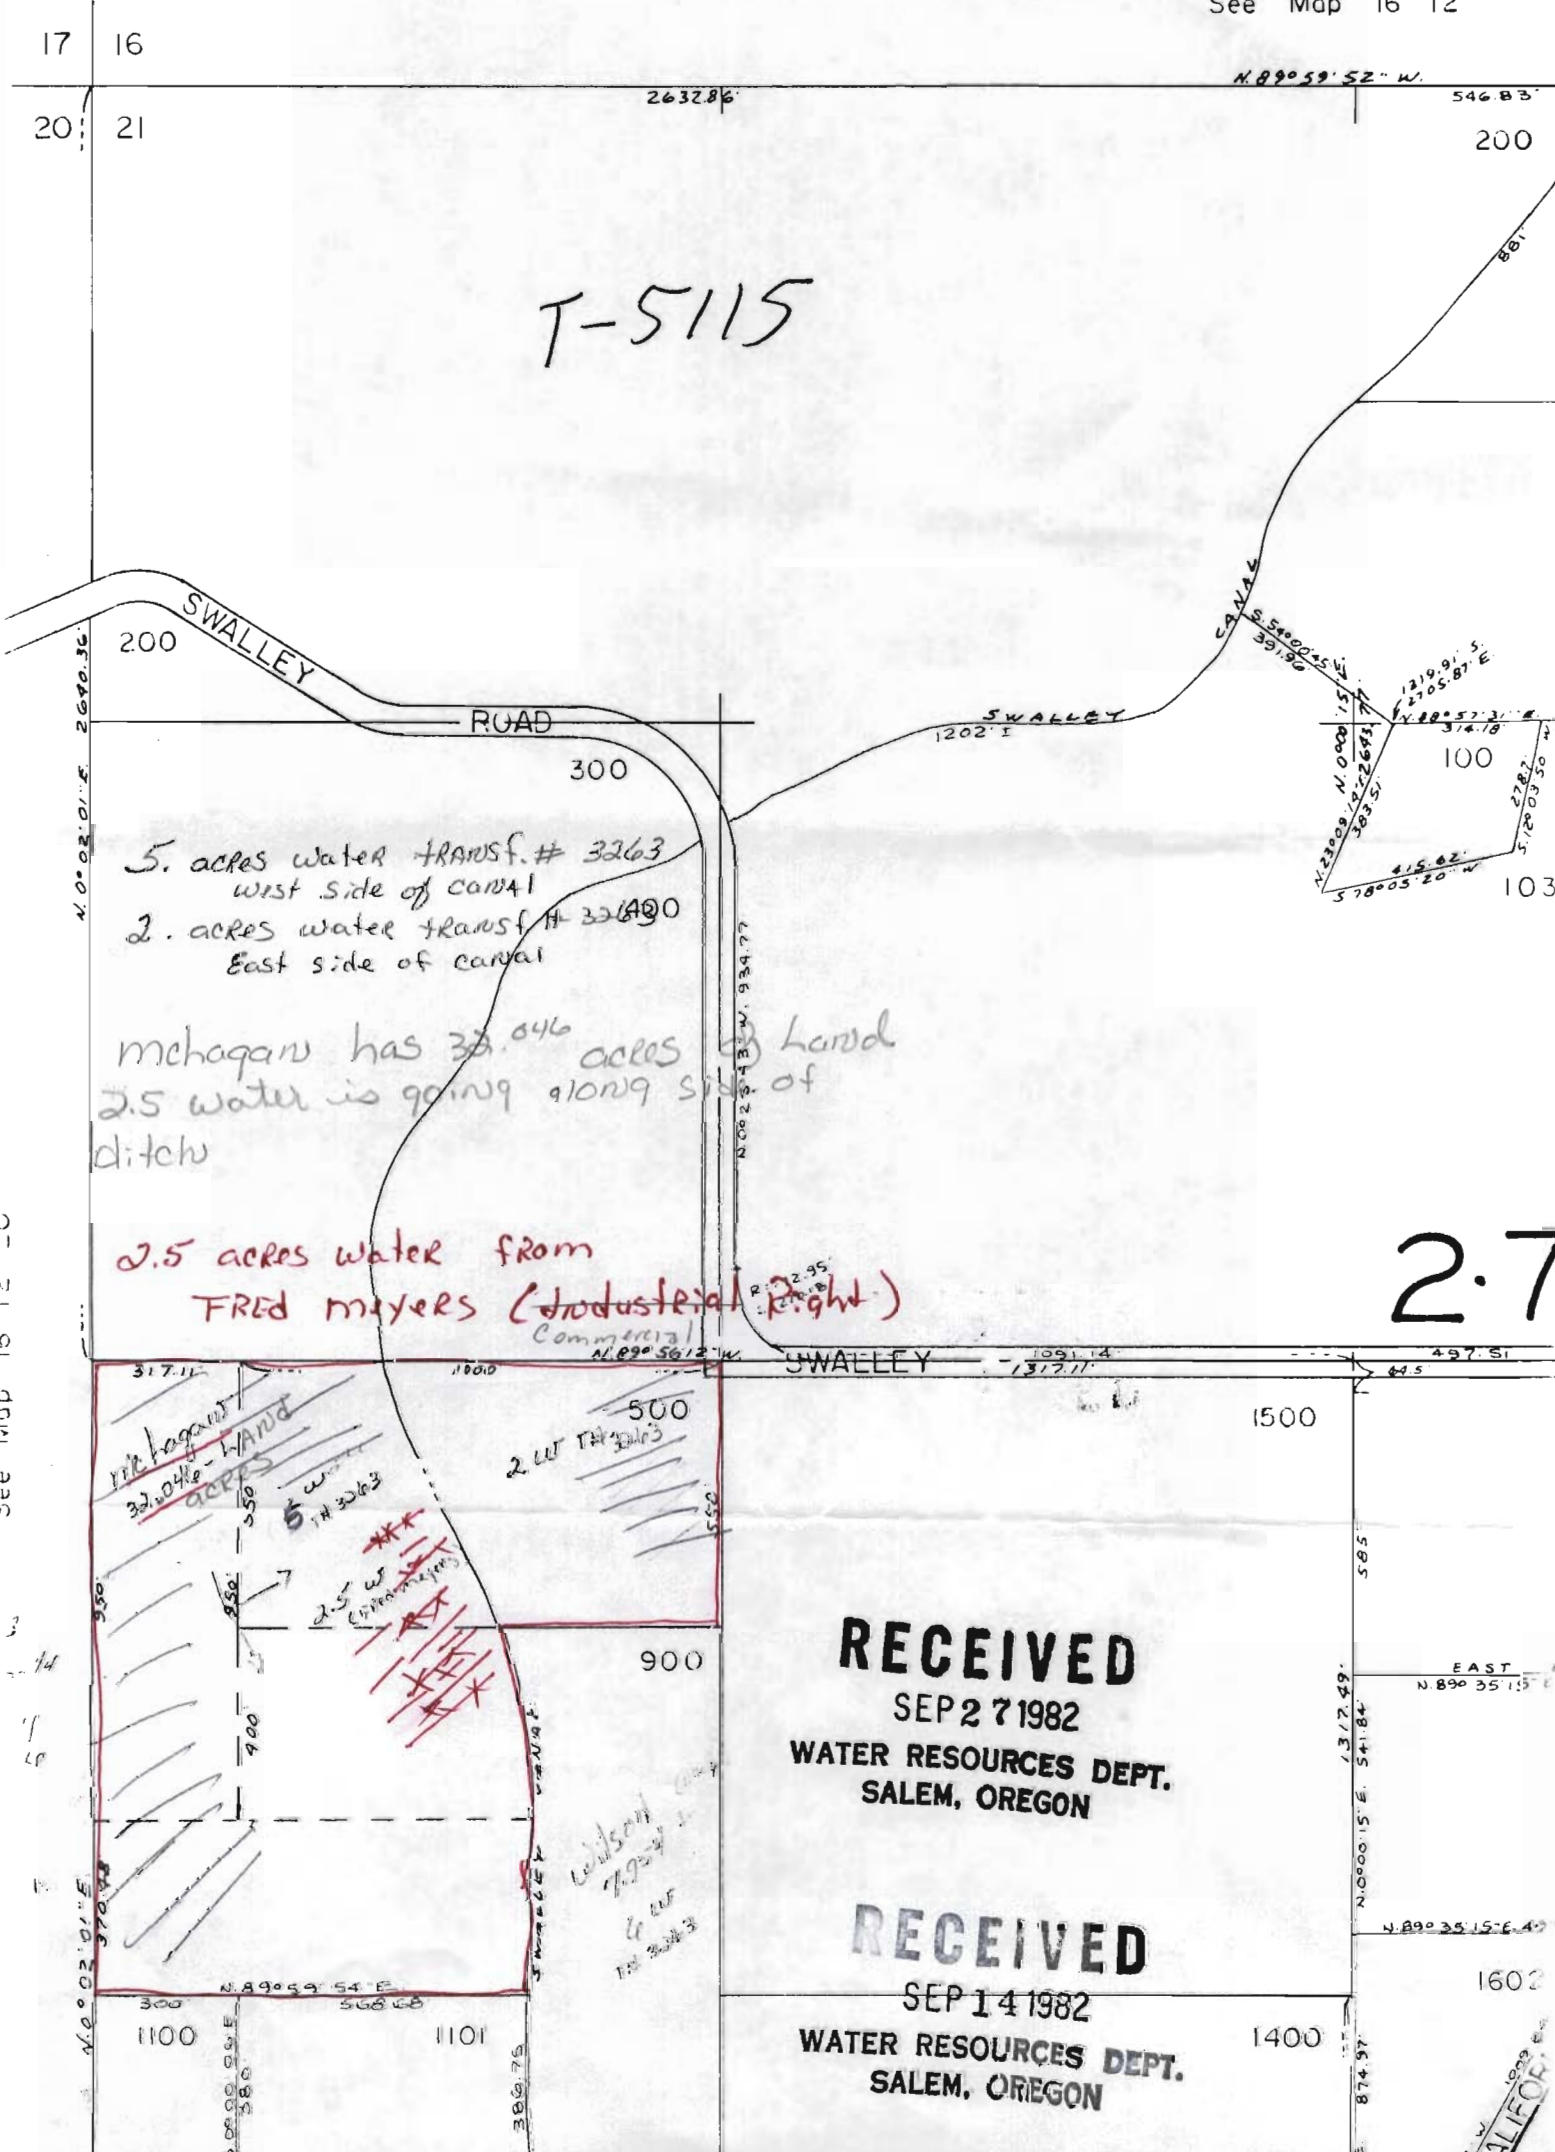


RECEIVED
 SEP 27 1982
 WATER RESOURCES DEPT.
 SALEM, OREGON

RECEIVED
 SEP 14 1982
 WATER RESOURCES DEPT.
 SALEM, OREGON

see map 16 12 - C

SALE OF

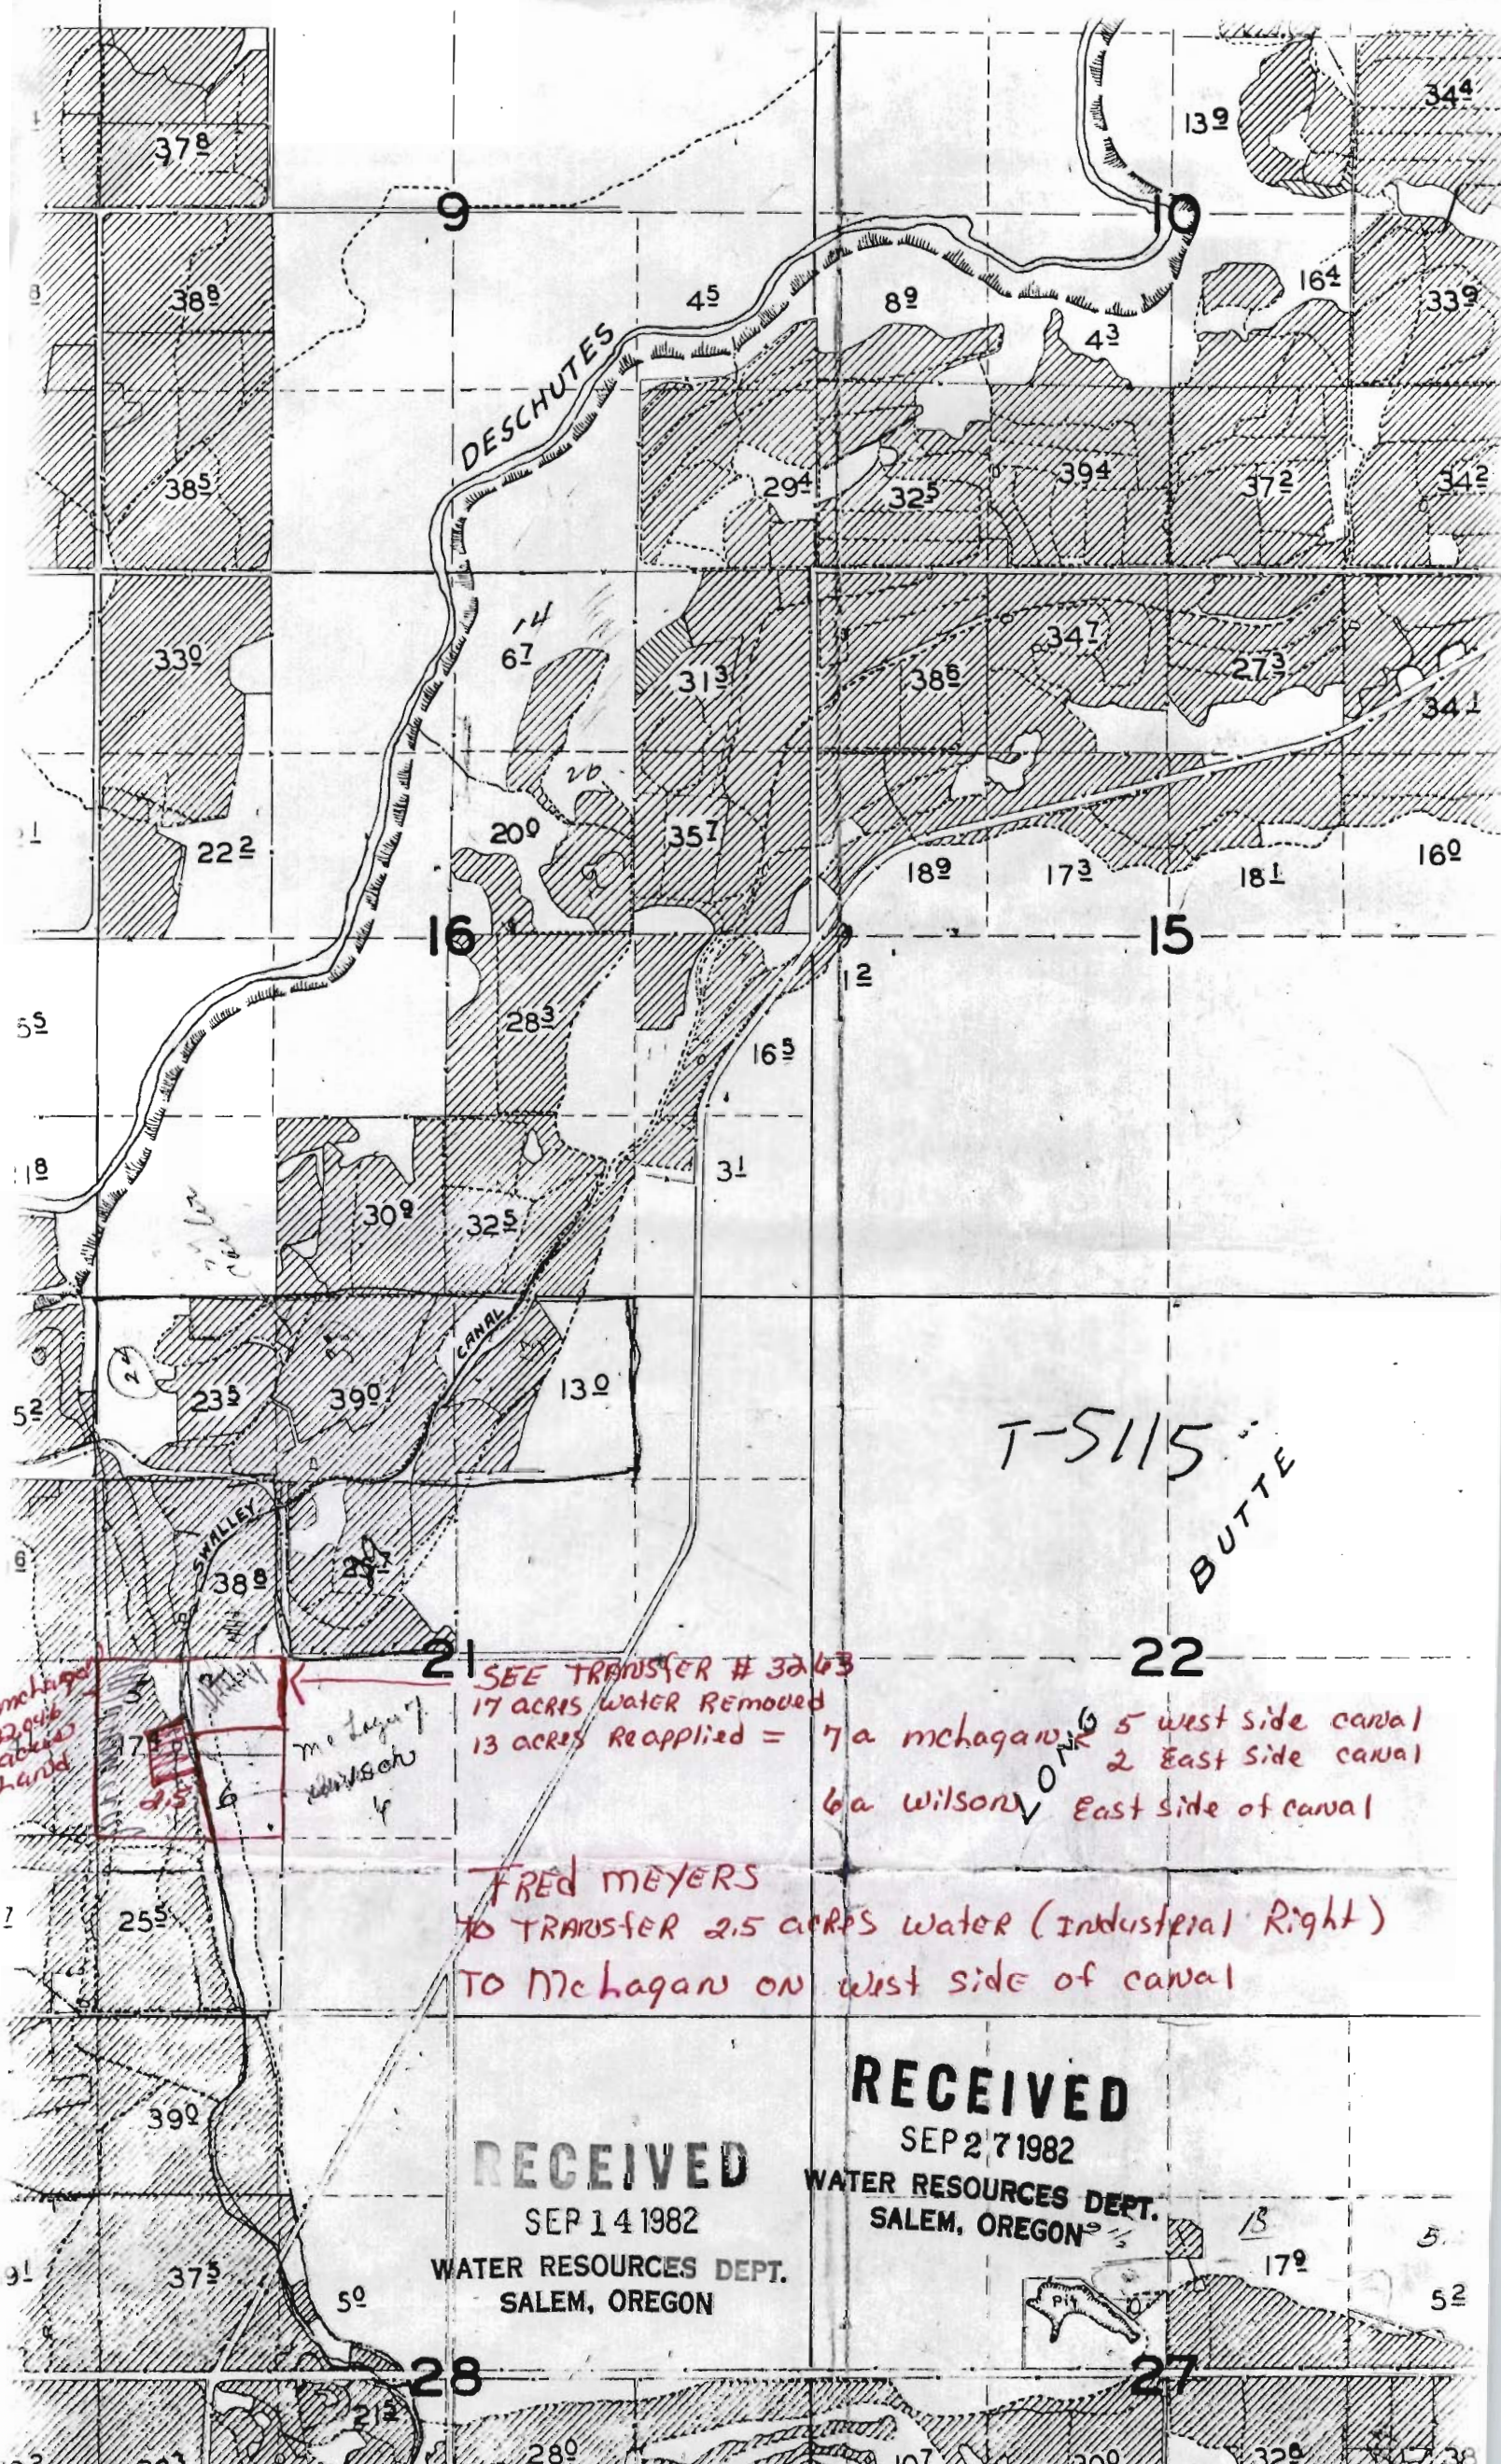

9

10

16

15

21

22

SEE TRANSFER # 3263
 17 ACRES WATER REMOVED
 13 ACRES REAPPLIED =

7a mchagan 5 west side canal
 2 East side canal
 6a Wilson 0 1/2 East side of canal

FRED MEYERS
 TO TRANSFER 2.5 ACRES WATER (INDUSTRIAL RIGHT)
 TO Mchagan ON WEST SIDE OF CANAL

T-5115
 BUTTE

RECEIVED

SEP 14 1982

WATER RESOURCES DEPT.
 SALEM, OREGON

RECEIVED

SEP 27 1982

WATER RESOURCES DEPT.
 SALEM, OREGON

28

27