


T.35S., R.4W., W.M.

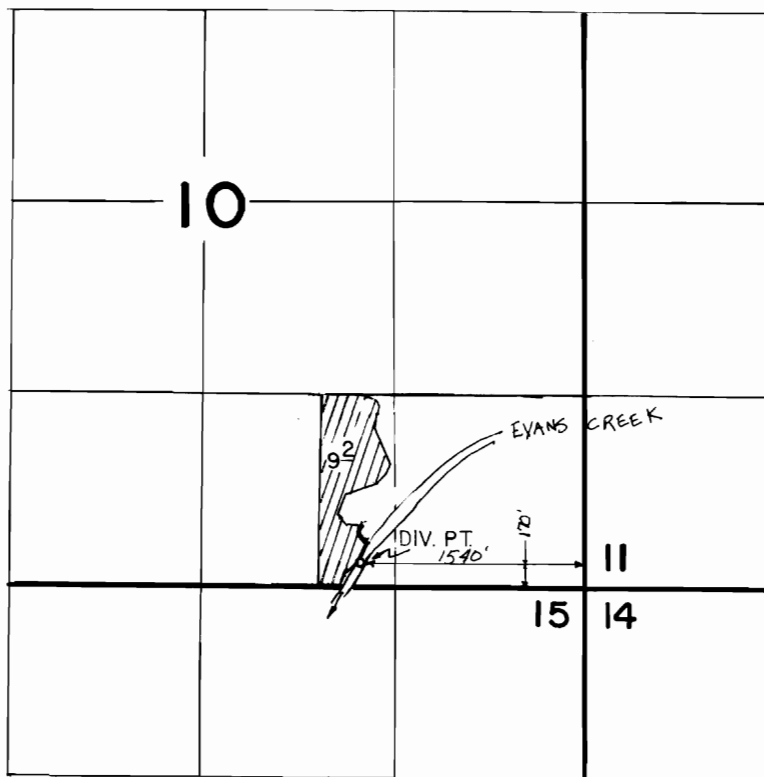

FINAL PROOF SURVEY
UNDER

TRANSFER NO. 5126

IN NAME OF

JAMES W. BARRET

Surveyed DEC. 12, 1983, by B. S. JAMES