


PROPOSED WATER DISTRIBUTION

TWP 38 SOUTH RANGE 10E 11 1/2 EAST SECTIONS SHOWN BELOW

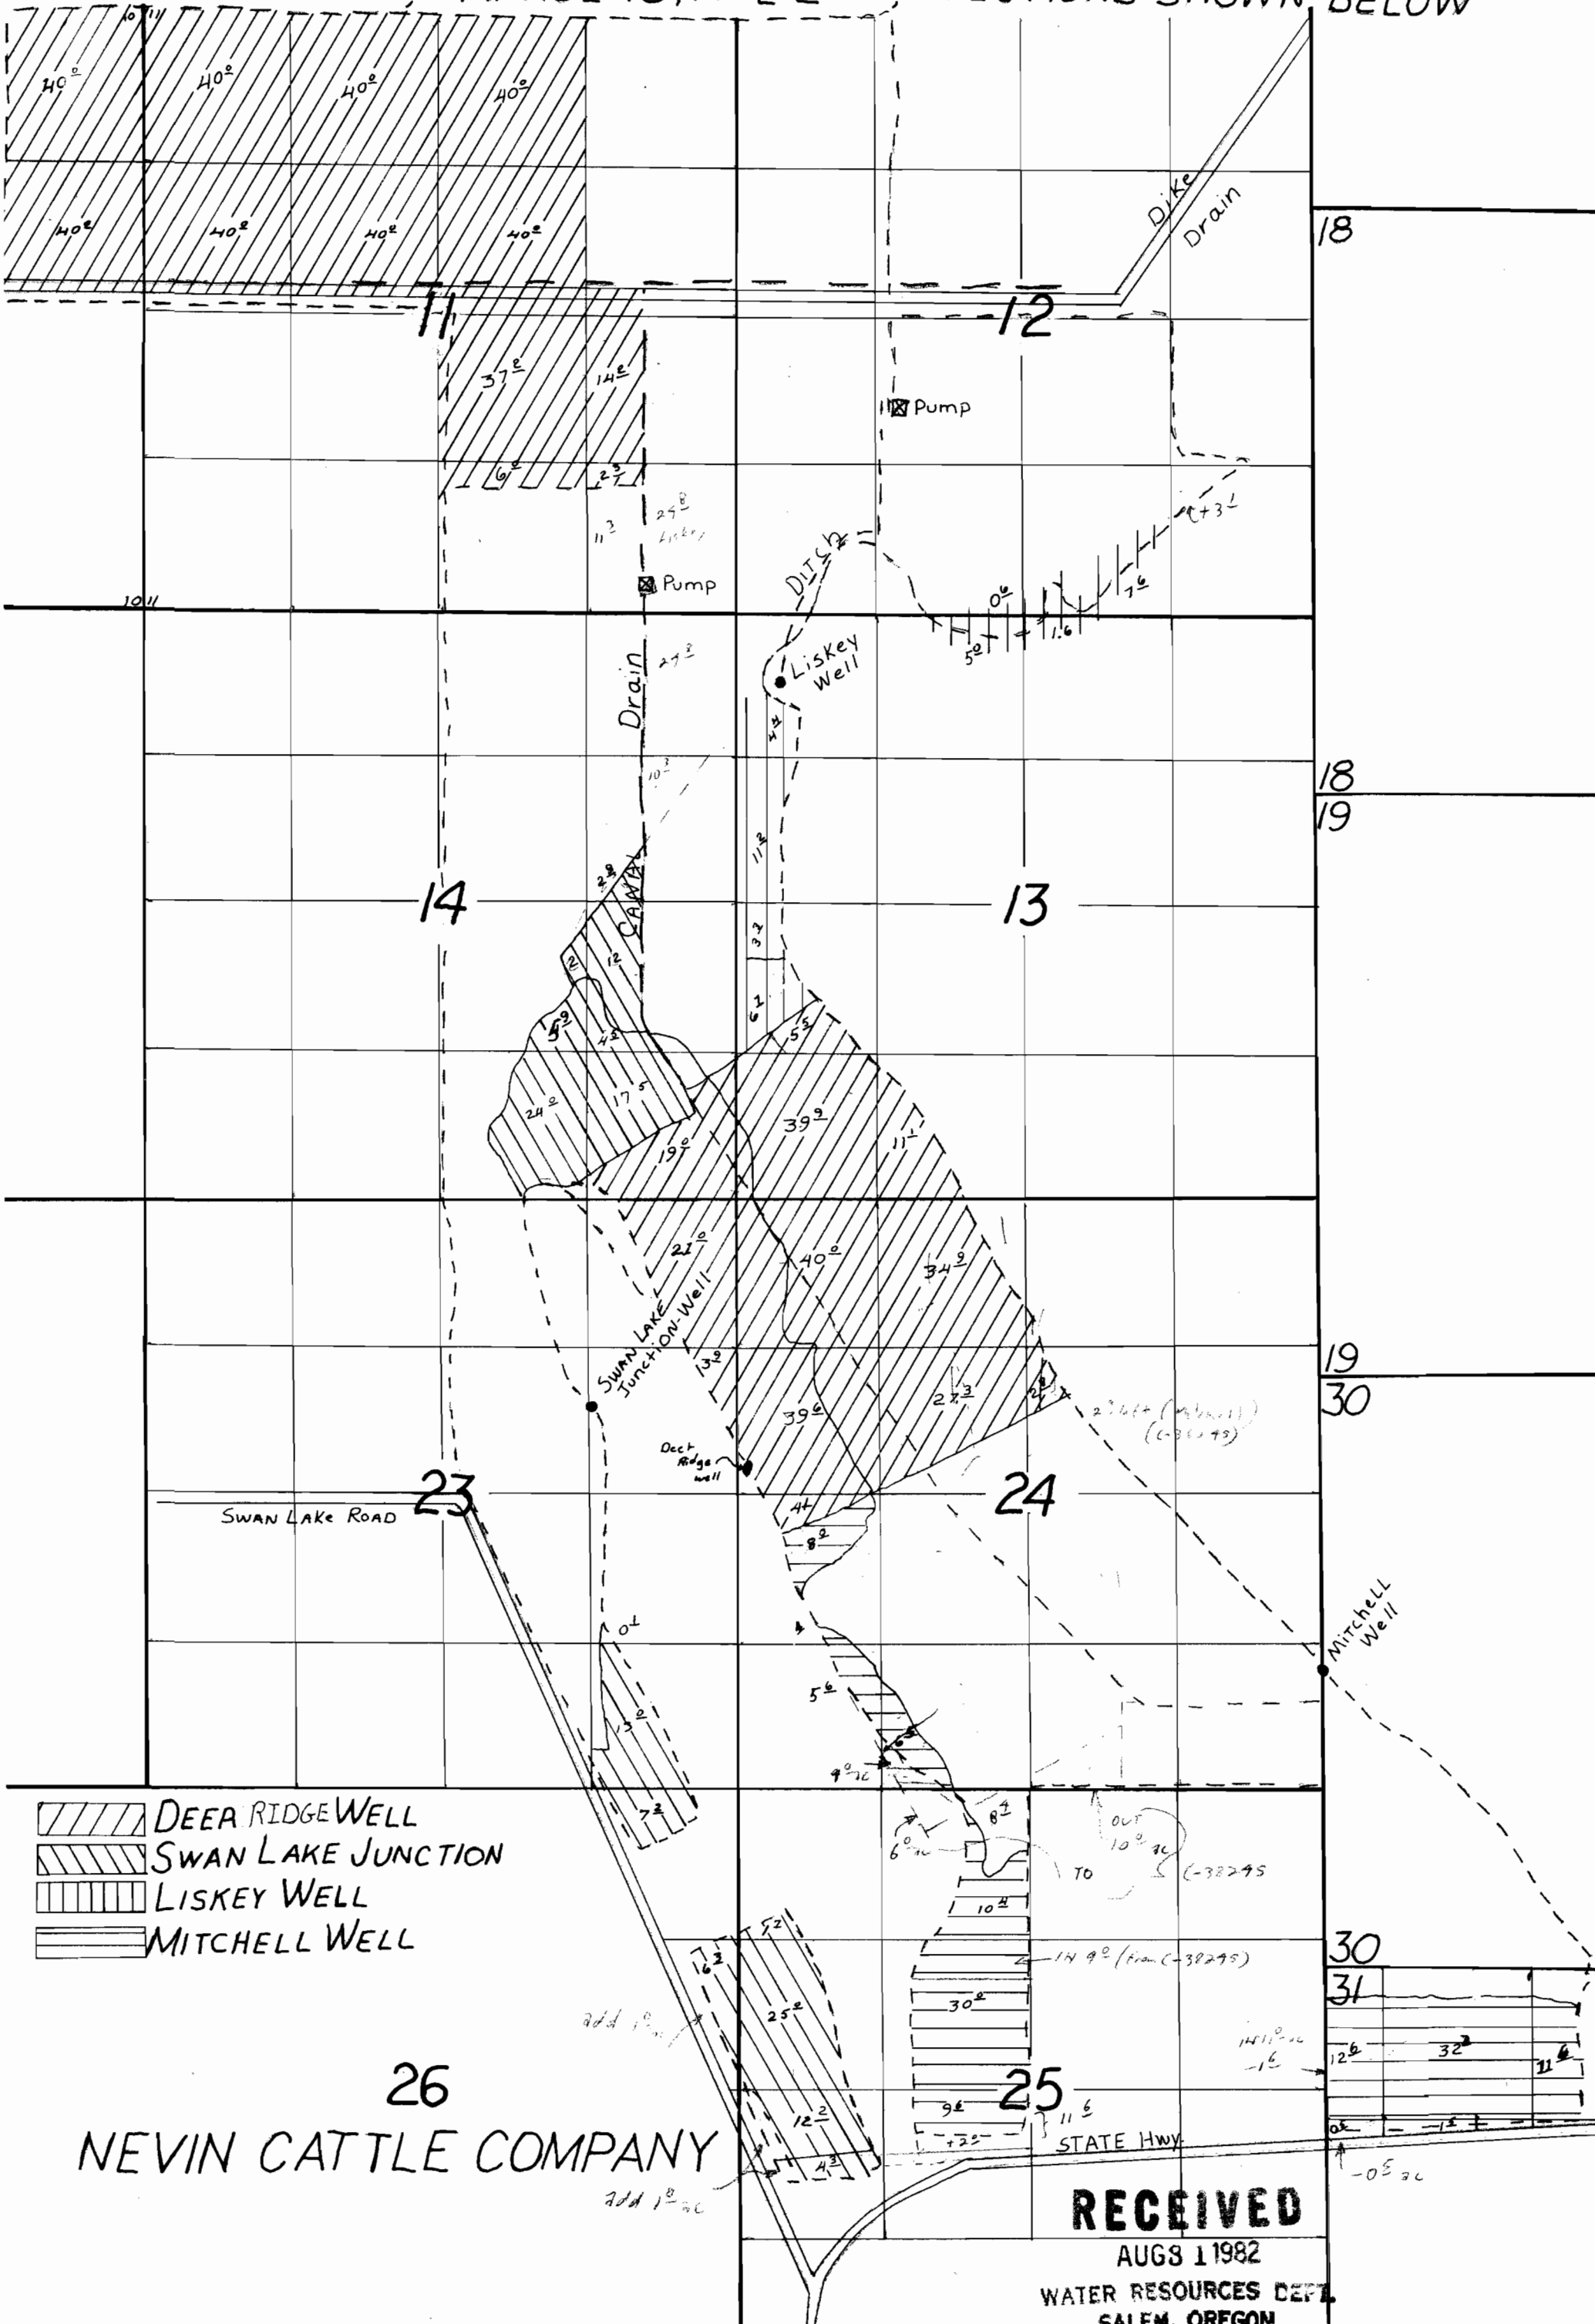

RECEIVED

AUG 1 1982

WATER RESOURCES DEPT
