


SECTION 22T.16S. R. 11E. W.M.

1" = 400'

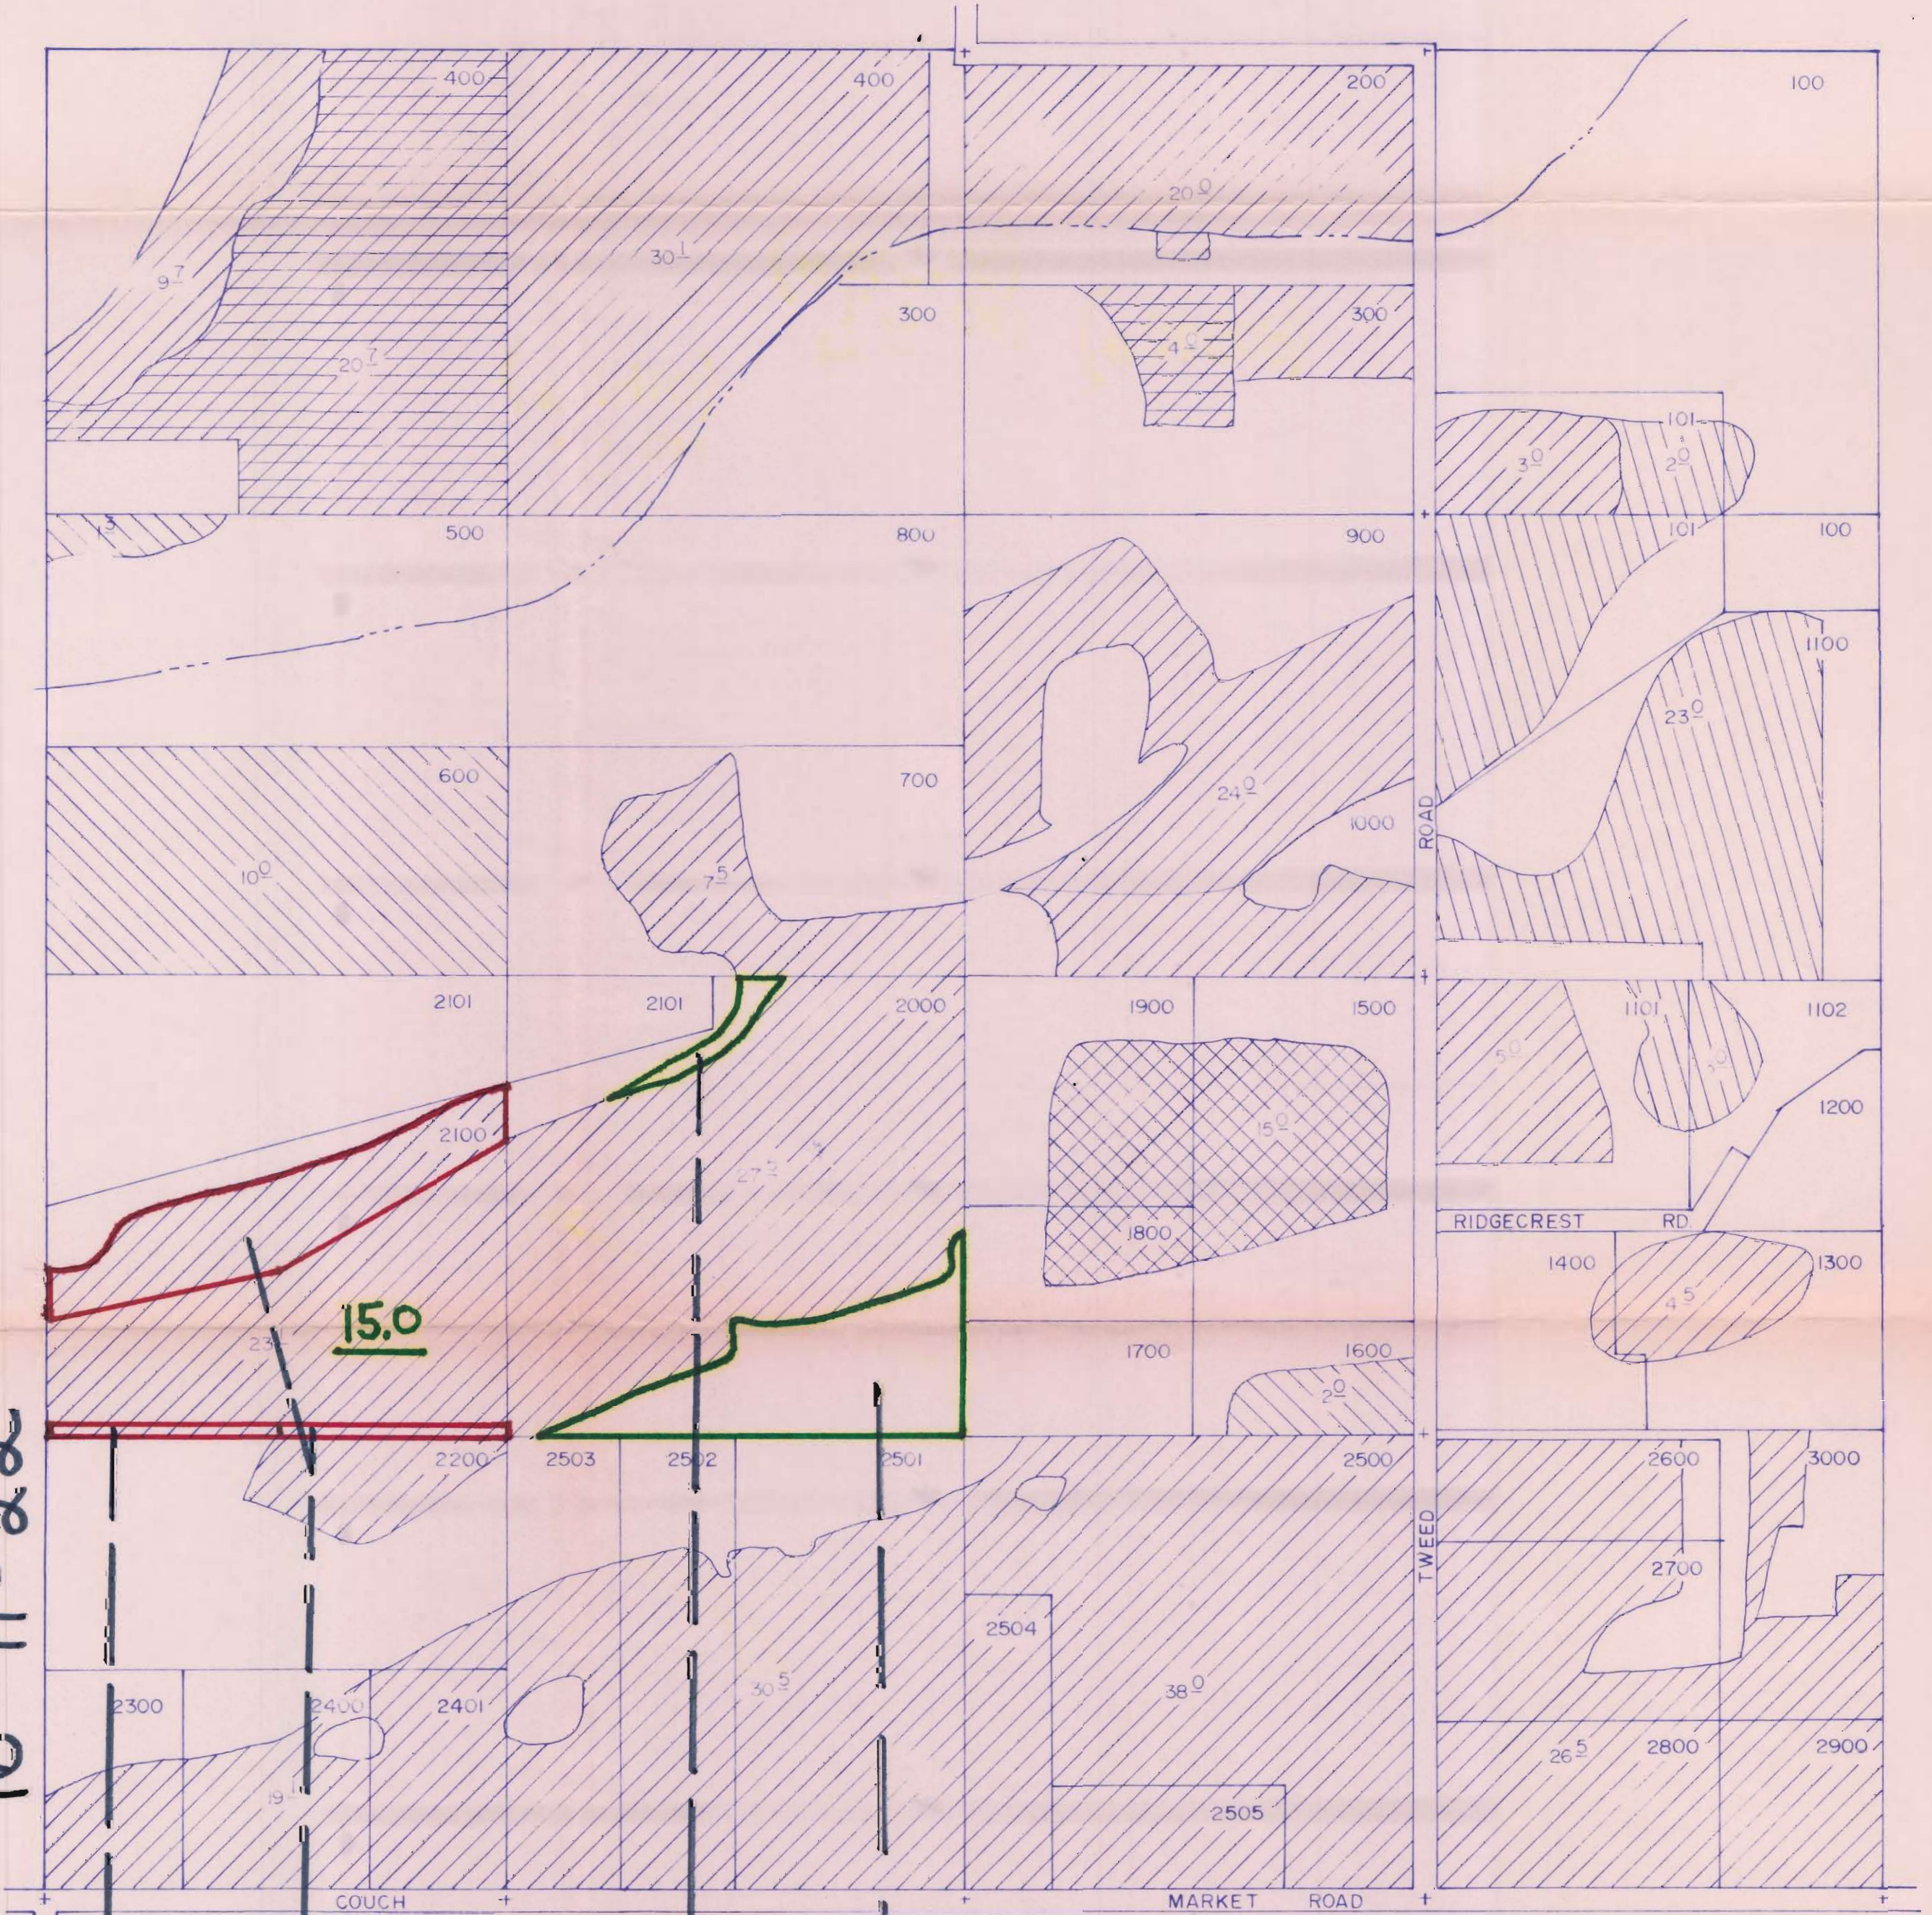

6-11-22

.5 OFF
(#31410)

7.6 OFF
(#26508)

.5 ON
(#31410)

7.6 ON
(#26508) (#26508)

