


SECTION 35 T.16 S. R.11 E. W.M.

1" = 400'

T-4965

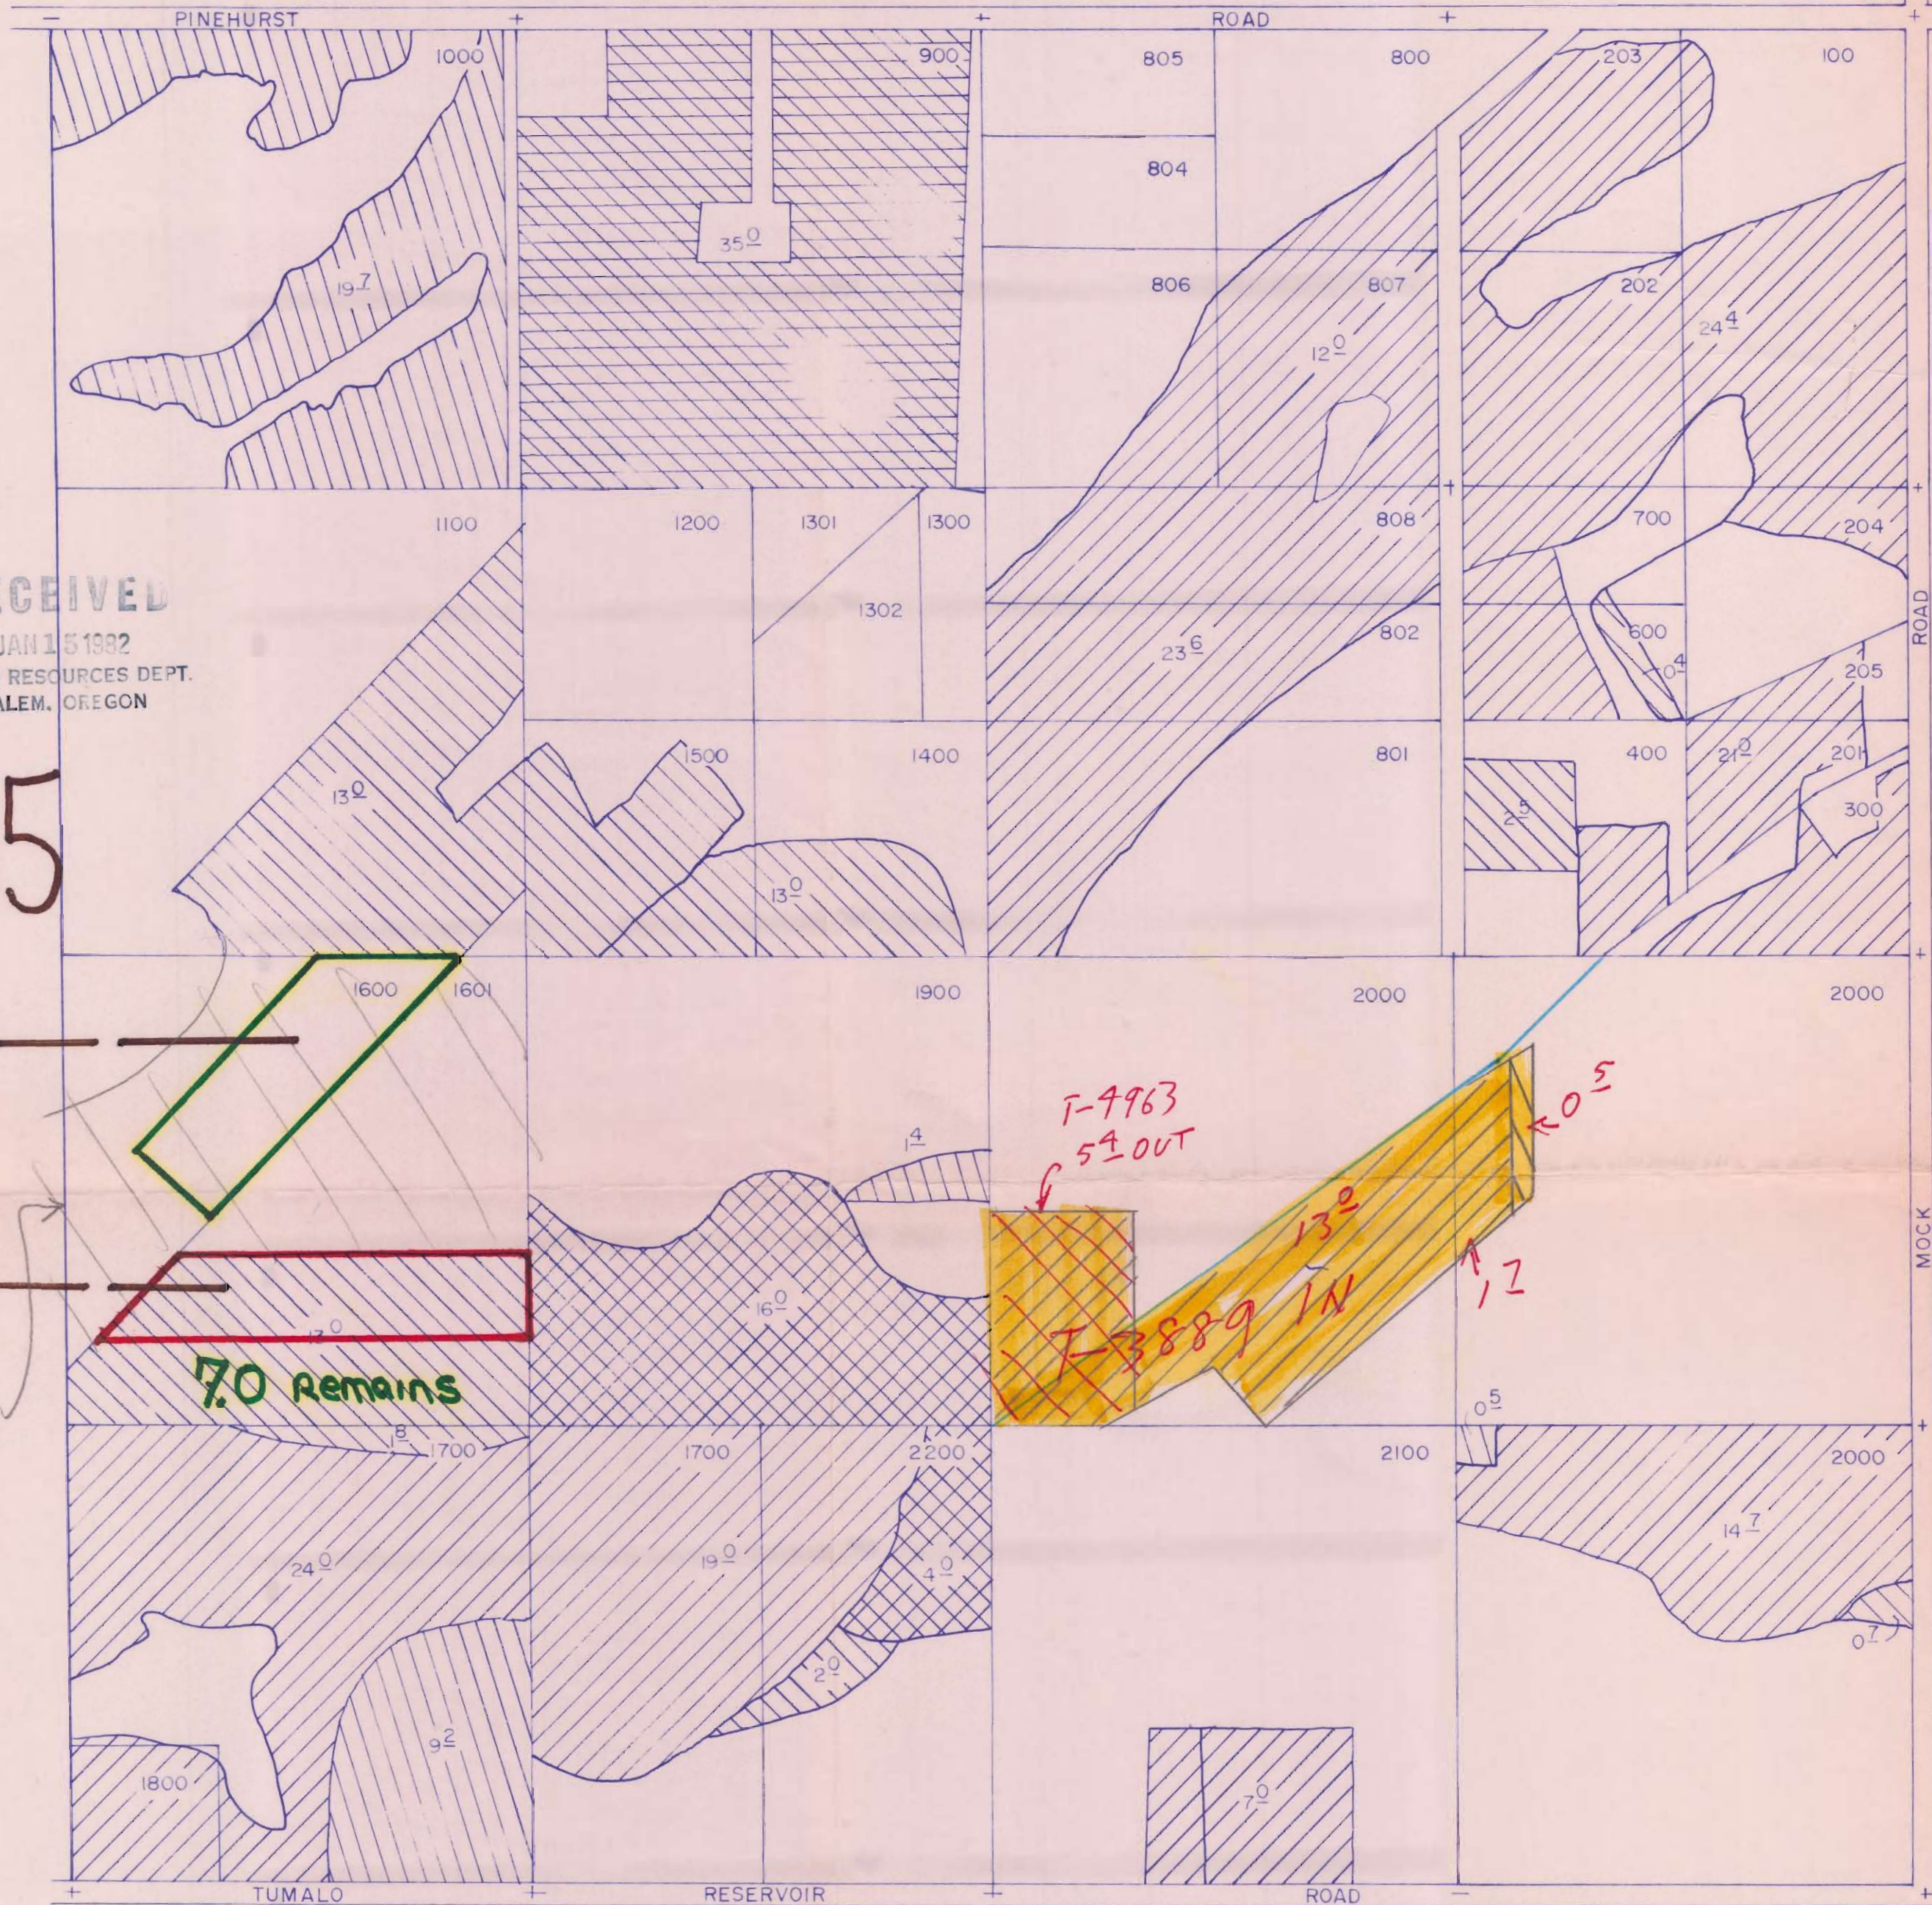

RECEIVED
 JAN 15 1982
 WATER RESOURCES DEPT.
 SALEM, OREGON

16-11-35

6.0 ON

6.0 OFF

L-178 Look
 23.0 acres from

7.0 Remains

T-4963



