

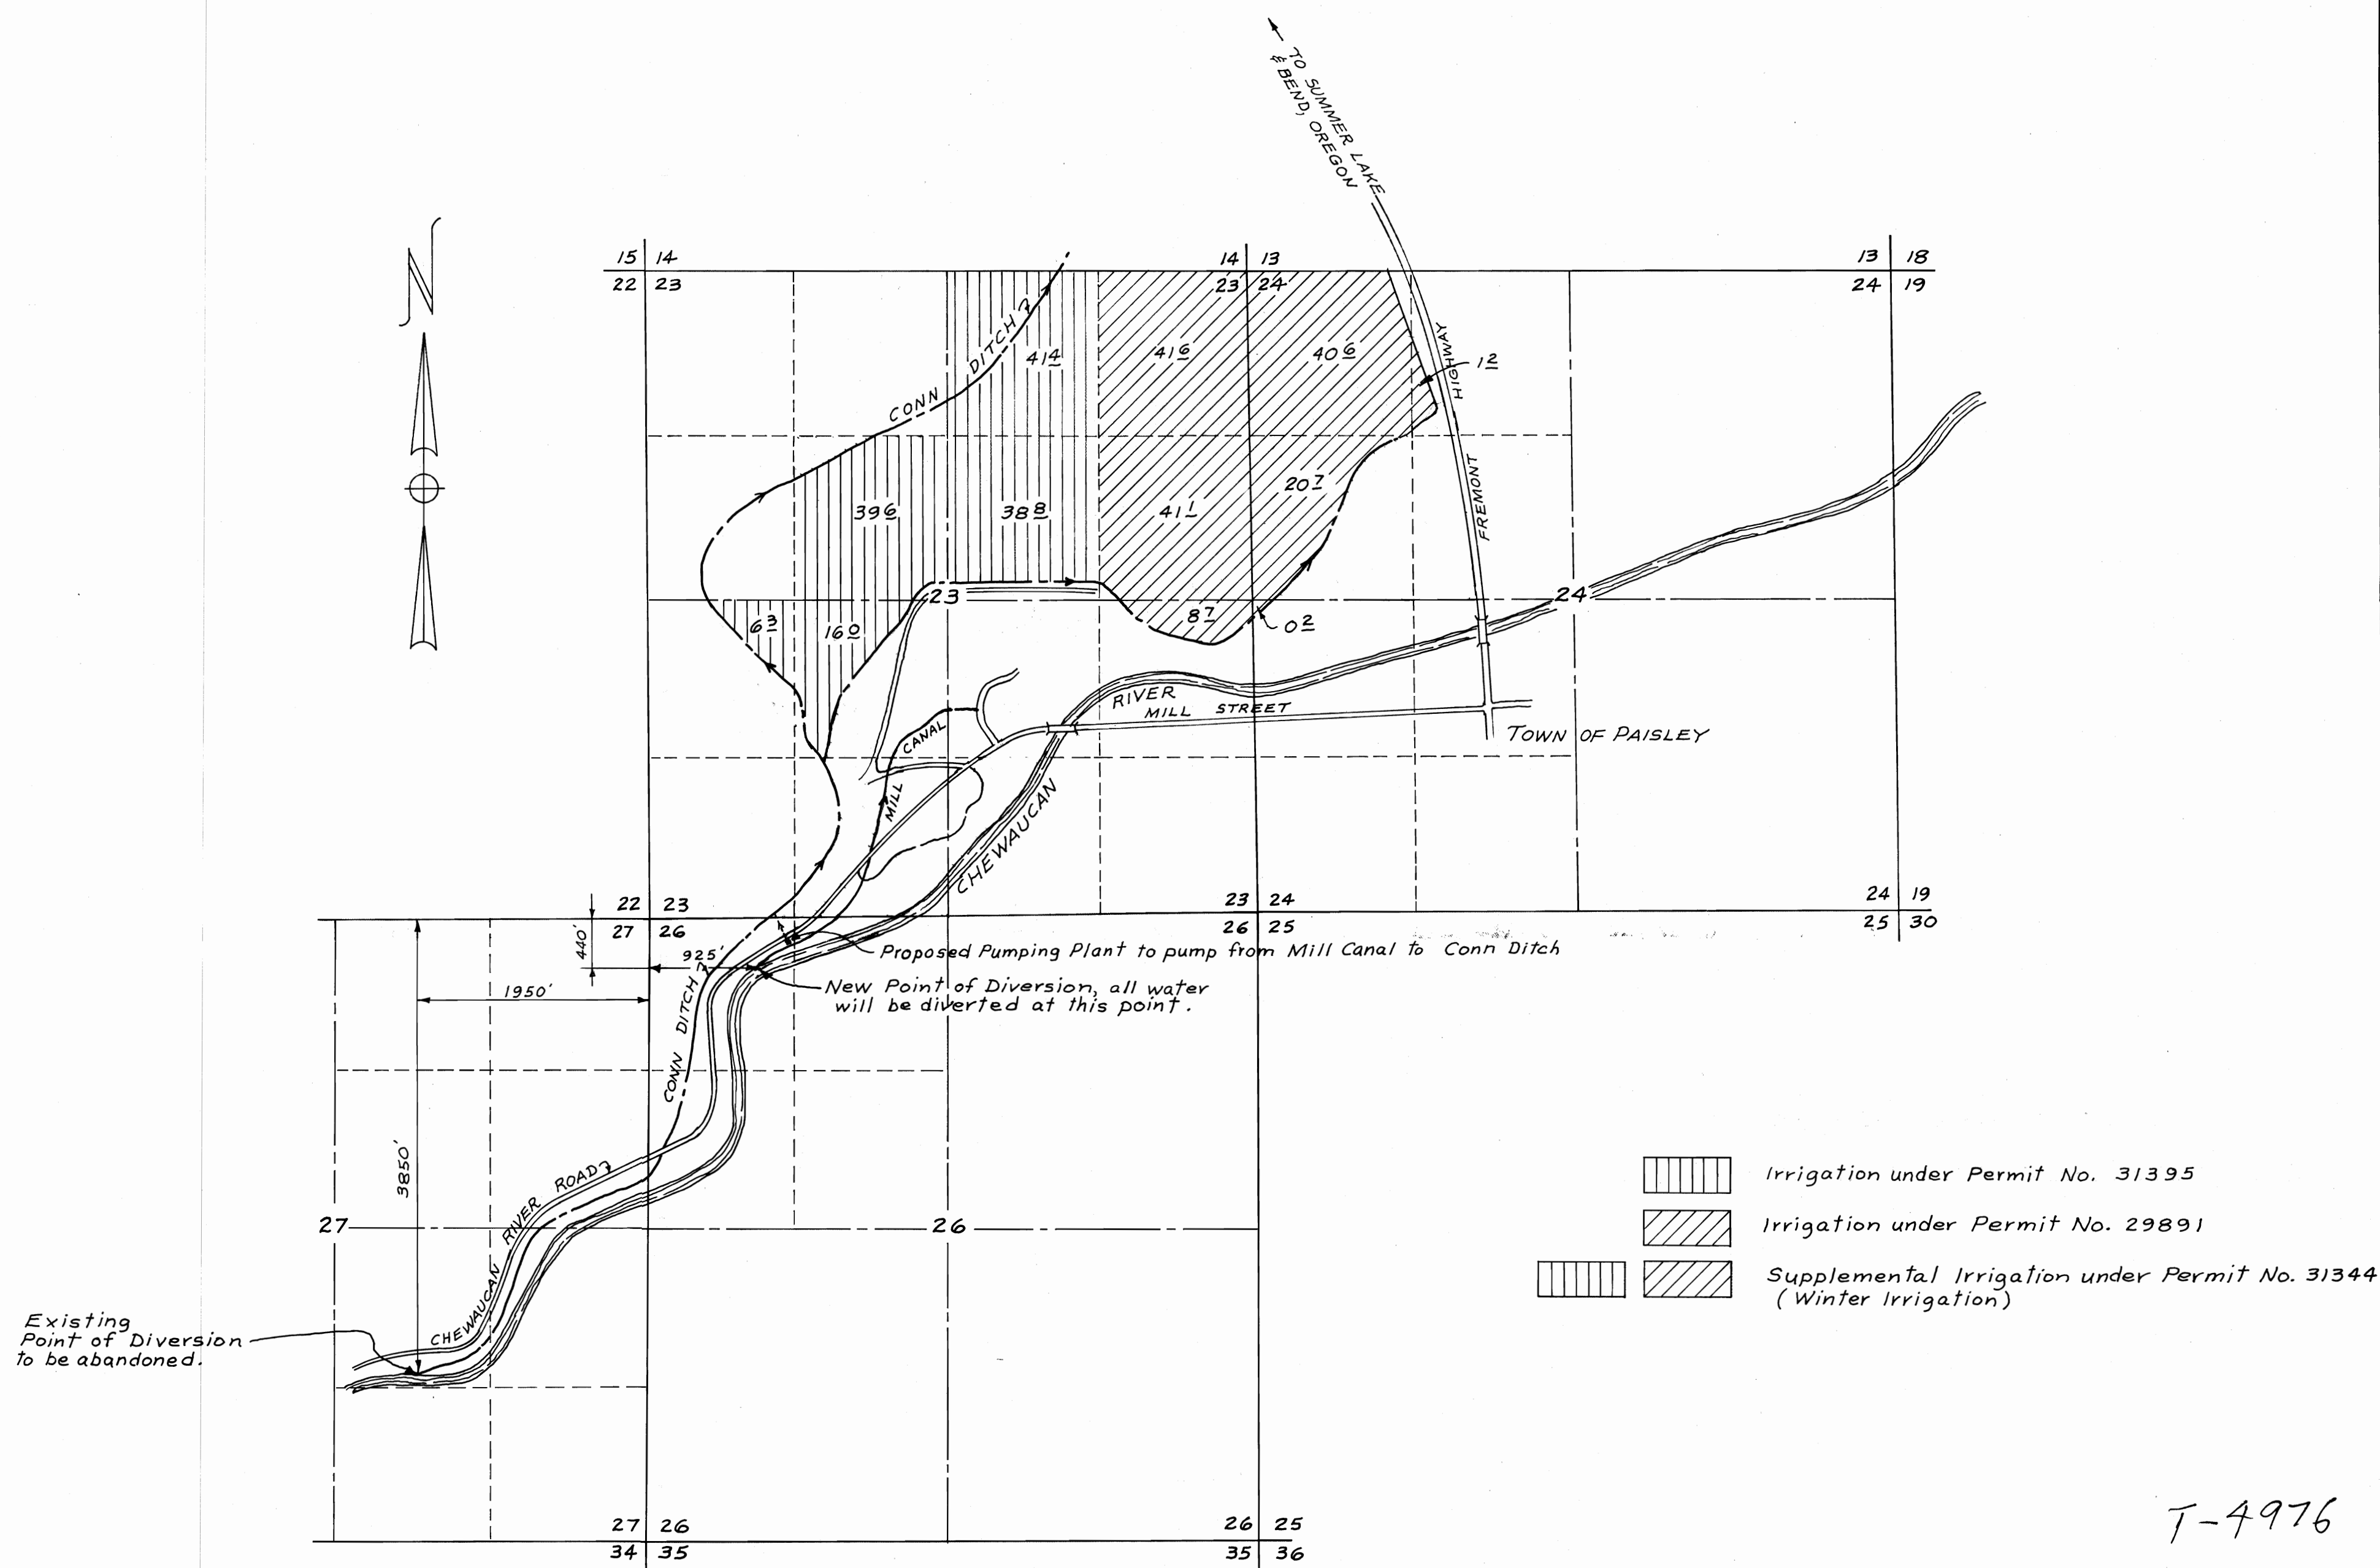


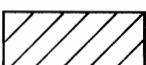

T. 33 S., R. 18 E., W. M.

-  Irrigation under Permit No. 31395
-  Irrigation under Permit No. 29891
-  Supplemental Irrigation under Permit No. 31344 (Winter Irrigation)

T-4976

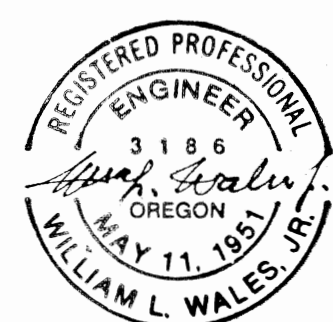

MAP SHOWING
CHANGE IN POINT OF DIVERSION
for ROSS H. & DORIS COLAHAN
IN
T. 33 S., R. 18 E., W. M.
LAKE COUNTY, OREGON
Scale: 1" = 1000'
Map prepared by: WILLIAM L. WALES
& Associates
Consulting Engineers
Klamath Falls, Oregon
March, 1981