


T-5132

16-10-29

16-12-16

Deuce = 14 water
Transfer #3826 11.5 "
Transfer #4461 5. "

T-4461

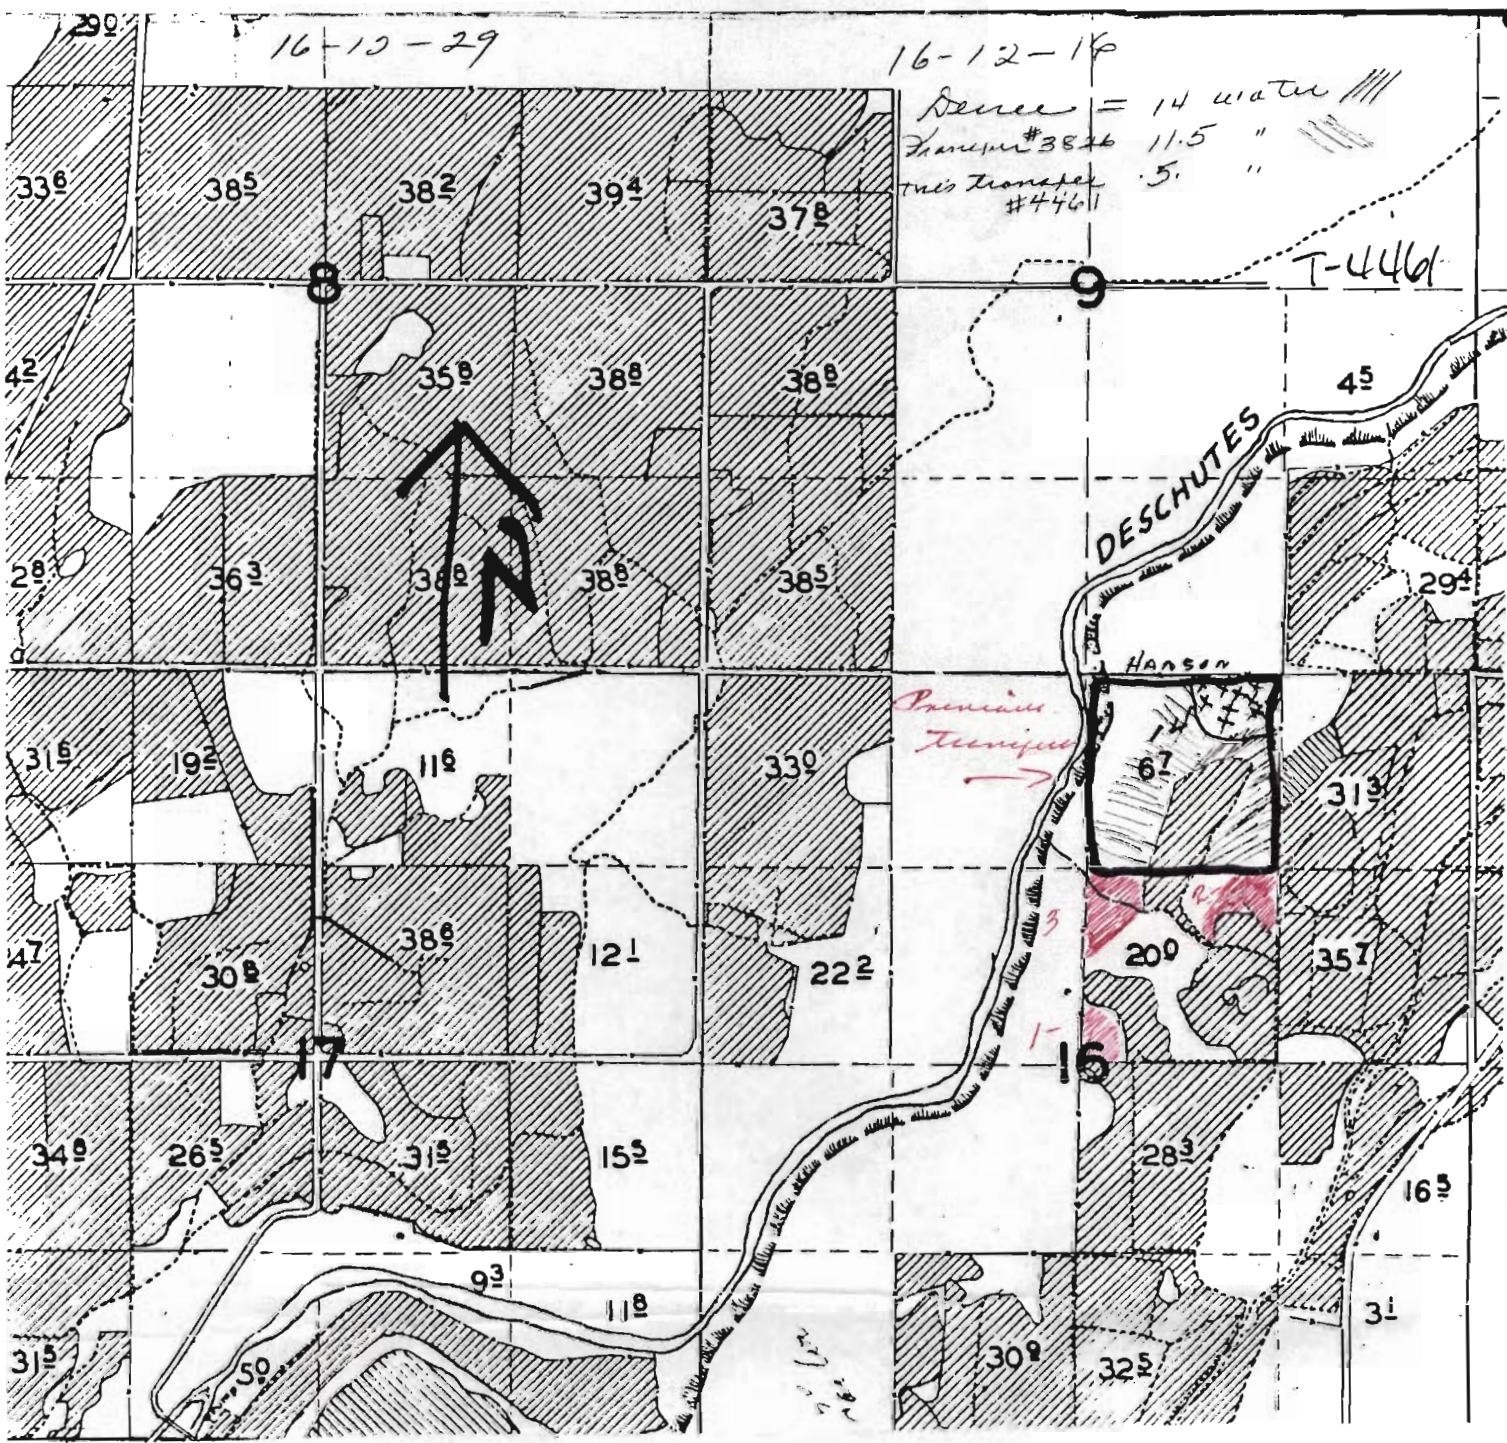

Transferred from 17-12-16

RECEIVED

OCT 18 1982

WATER RESOURCES DEPT.
SALEM, OREGON

T-5132



Page 158 James Price / Jack Hall.

transferring to 16-12-16

RECEIVED
OCT 18 1982
WATER RESOURCES DEPT.
SALEM, OREGON