


T-5134

17-12

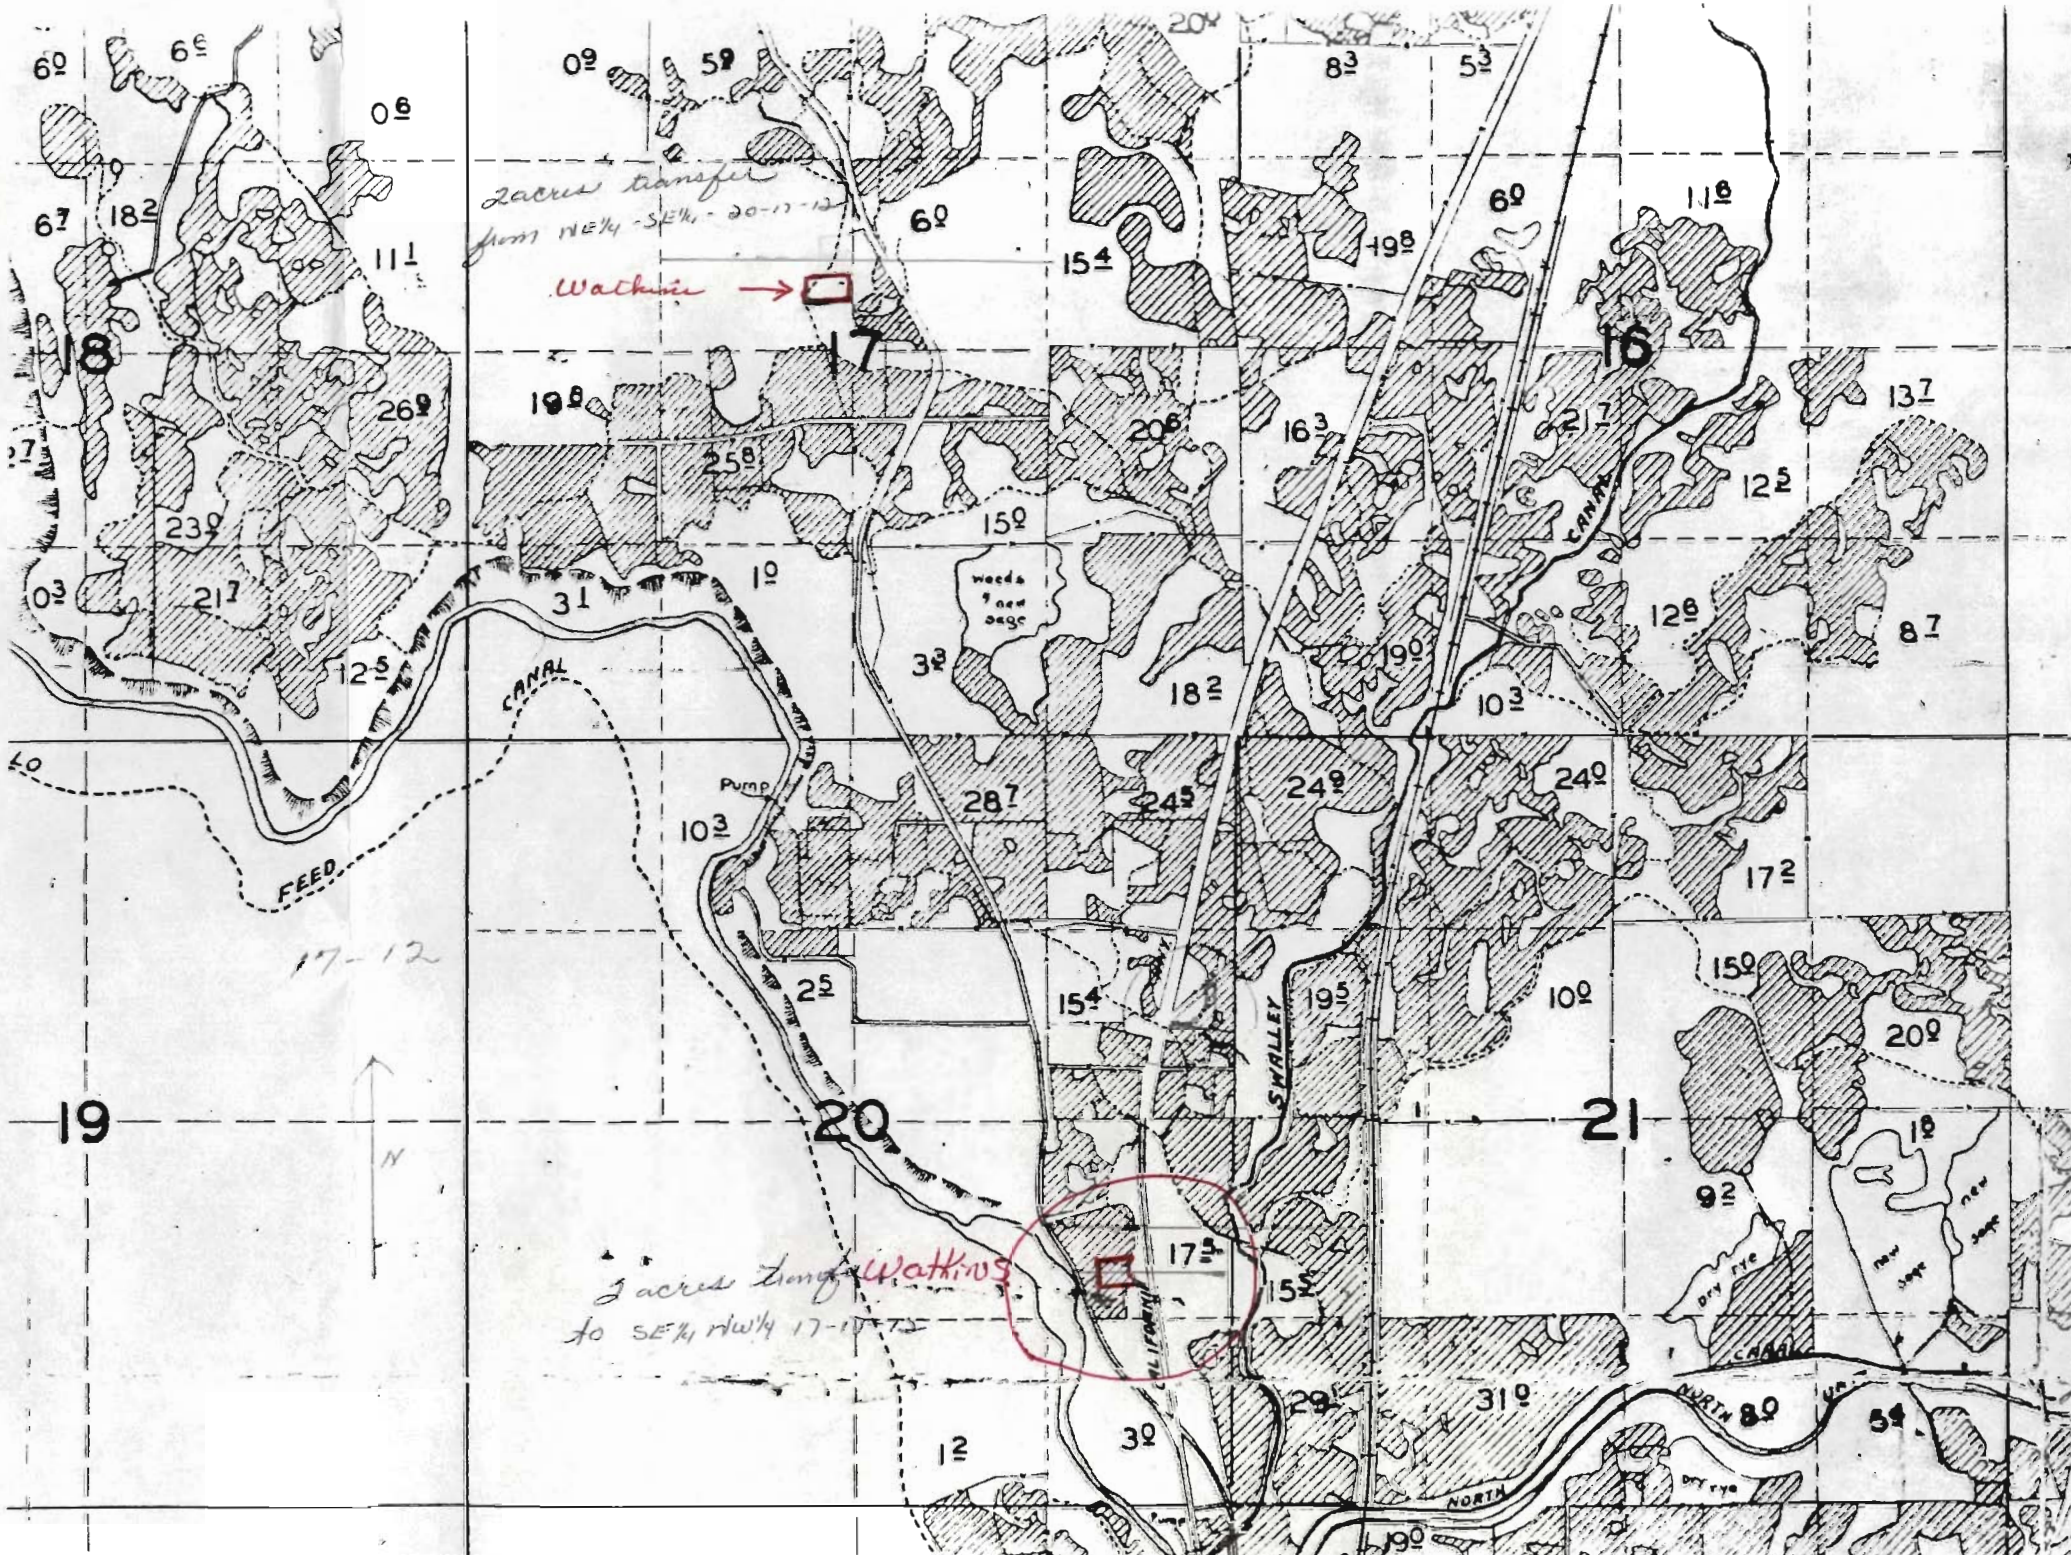

RECEIVED
 OCT 18 1982
 WATER RESOURCES DEPT.
 SALEM, OREGON