
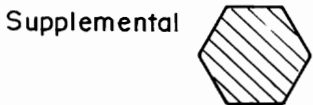


T. 34 S., R. 3 W., W. M.

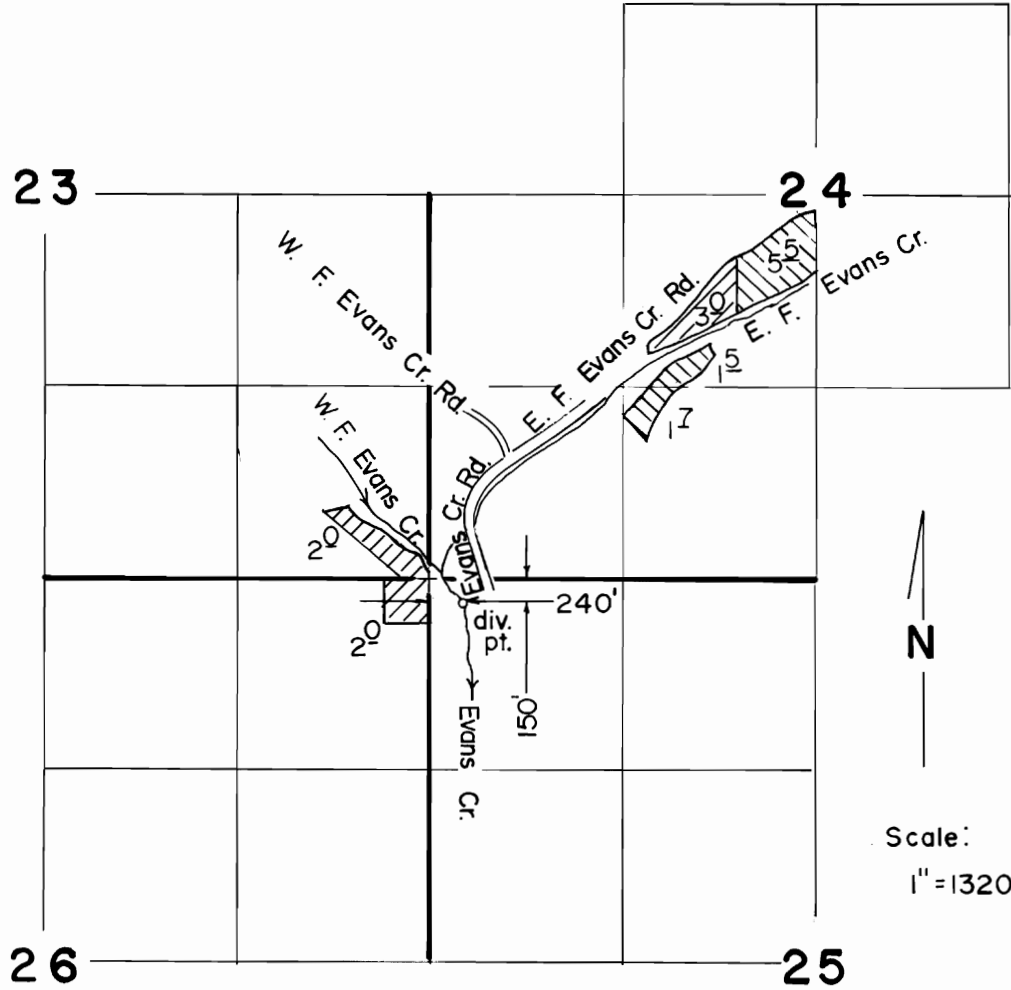

FINAL PROOF SURVEY
UNDER

TRANSFERS NO. 5139, 5140, 5141, 5142

Application No. Permit No.

IN NAME OF

ROBERT M. STOREY

Surveyed JUN....3... 19.8.7., by B....S.....JAMES...