

TOTAL - 19.4 ACRES OFF
4 1/2 MILE APPROX
T-5153

4.8
2.8 AC. OFF

8.5 AC
TRANSFERRED IN 1959

16.6 AC. OFF


18.56 AC
DECREE Right

TERREBONNE

RECEIVED
AUG 26 1982
WATER RESOURCES DEPT.
35 SALEM, OREGON

RECEIVED
NOV 3 1982
WATER RESOURCES DEPT.
SALEM, OREGON

T-5153

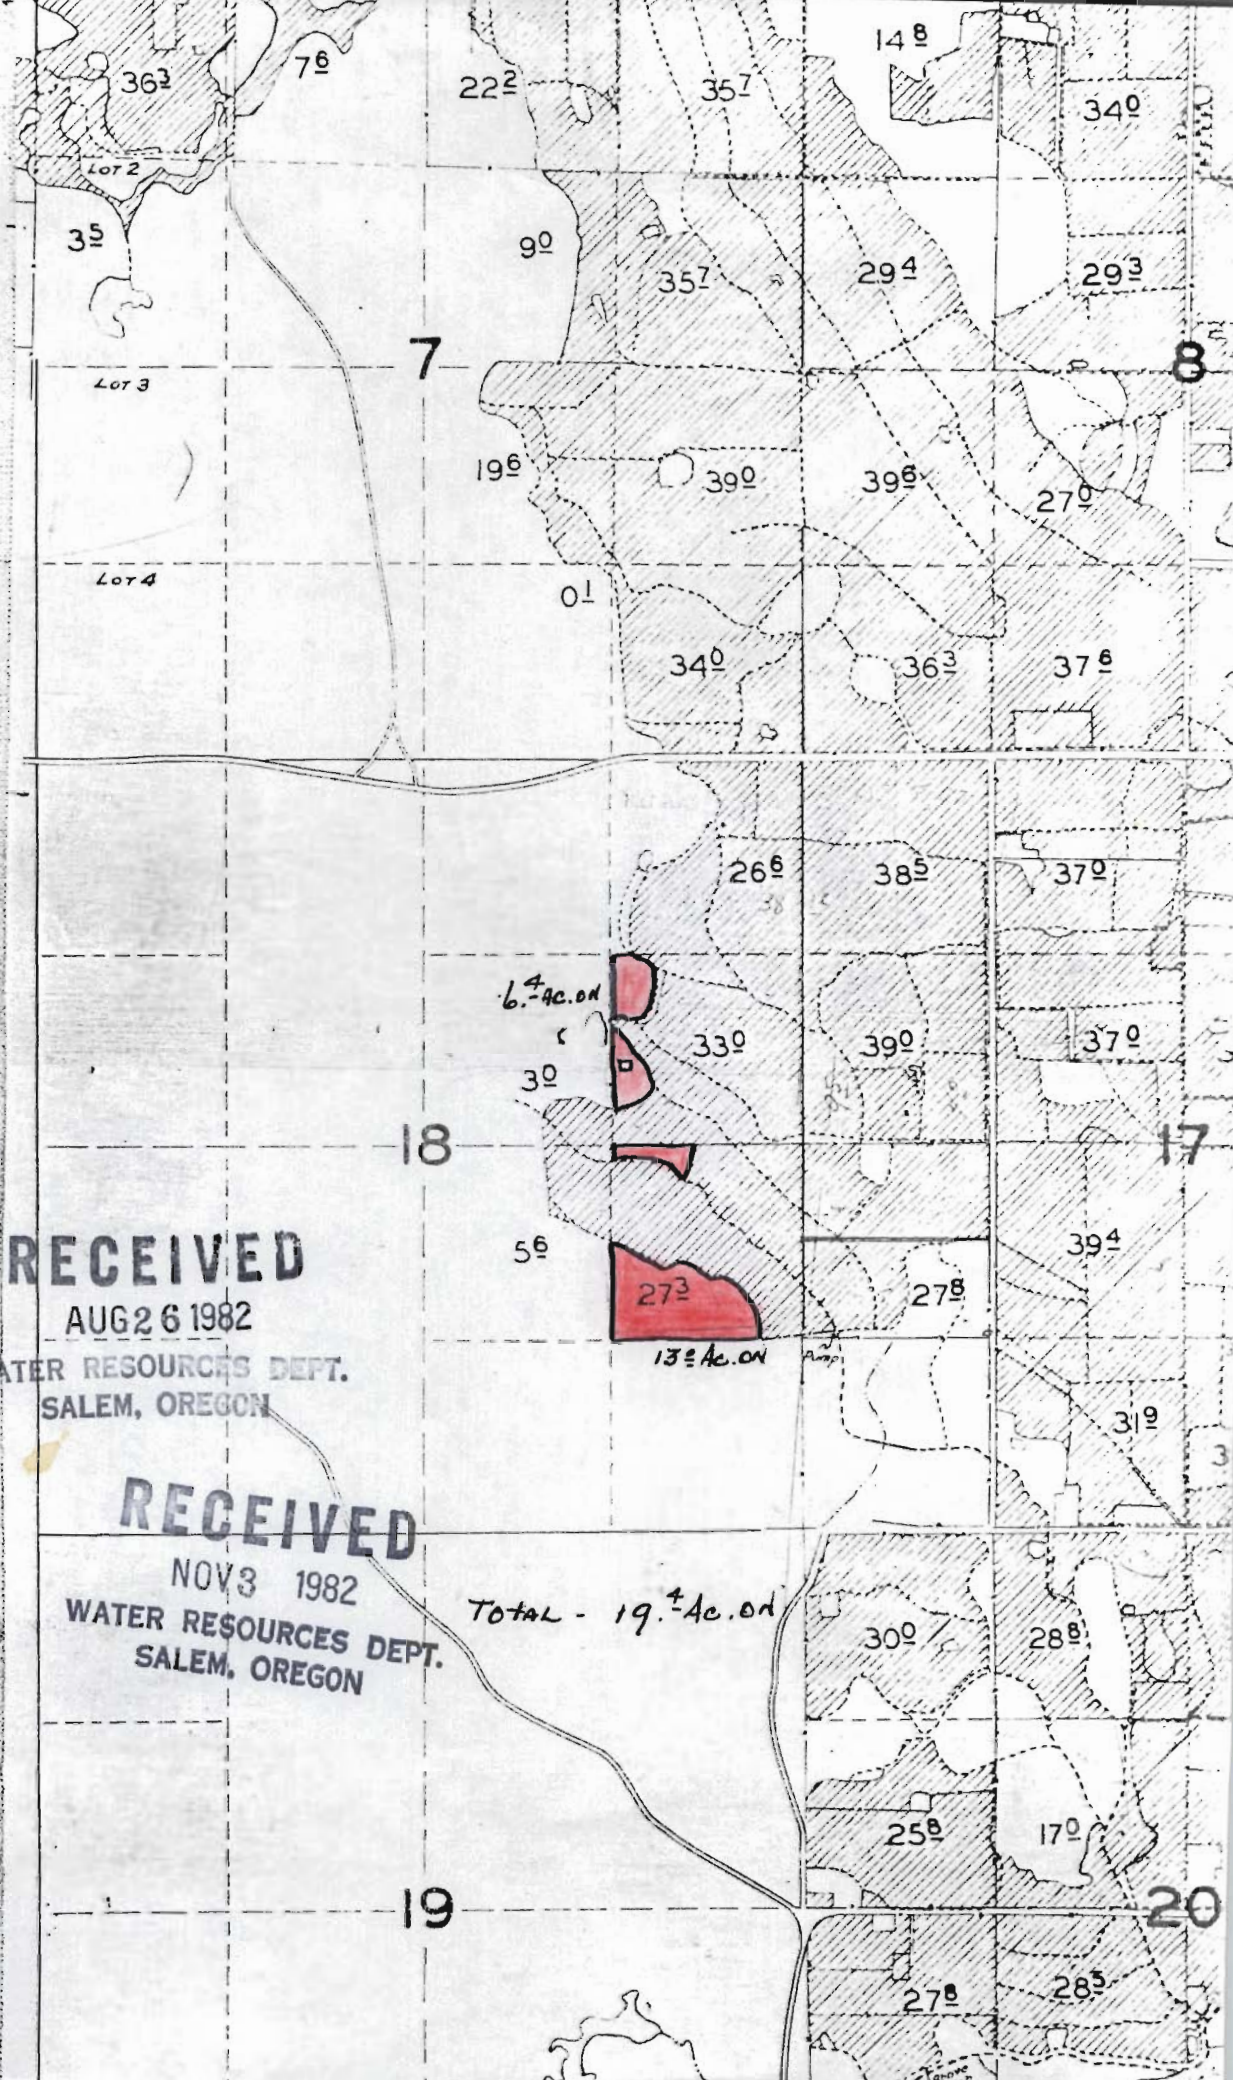

RECEIVED

AUG 26 1982

WATER RESOURCES DEPT.
SALEM, OREGON

RECEIVED

NOV 3 1982

WATER RESOURCES DEPT.
SALEM, OREGON

Total - 19.4 Ac. on