


T.1S., R.10E., W.M.

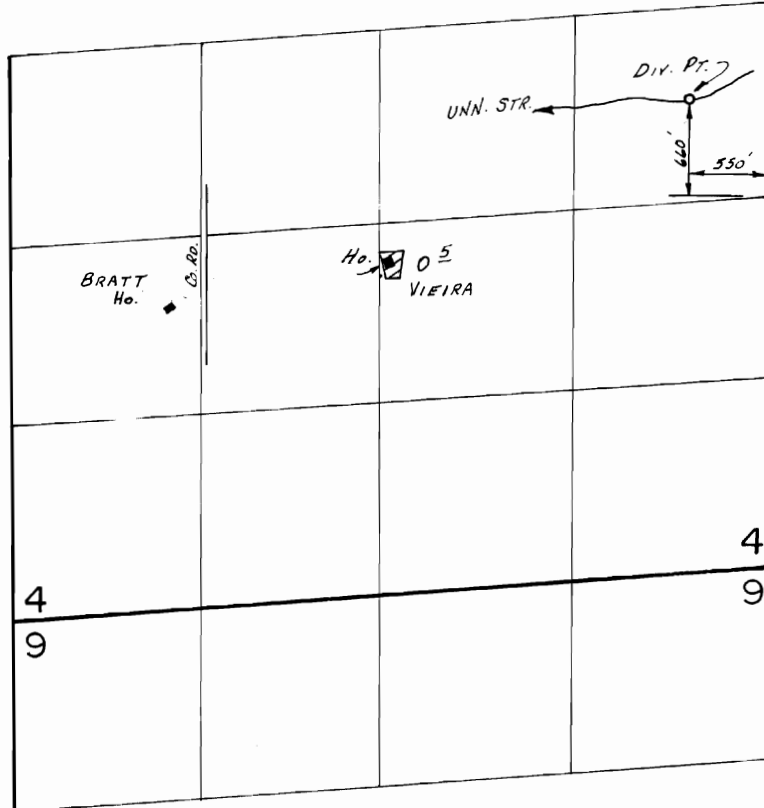

SCALE: 1" = 1320'

FINAL PROOF SURVEY UNDER

Transfer No. 5154
 64160 47452
 Application No. ~~64161~~ Permit No. ~~47496~~
 IN NAME OF

GEORGE & BOBBIE LOU VIEIRA & C. STEPHAN & L. JANE BRATT

Surveyed July 17, 1984, by L.M. TOLL

5/8/86
 36-83 NW 1/4
 PFS 1984 Z
 BUB