


TOWNSHIP 13^{AND} 14 SOUTH, RANGE 13 E

T-5158

RECEIVED

NOV 16 1982

WATER RESOURCES DEPT.
SALEM, OREGON

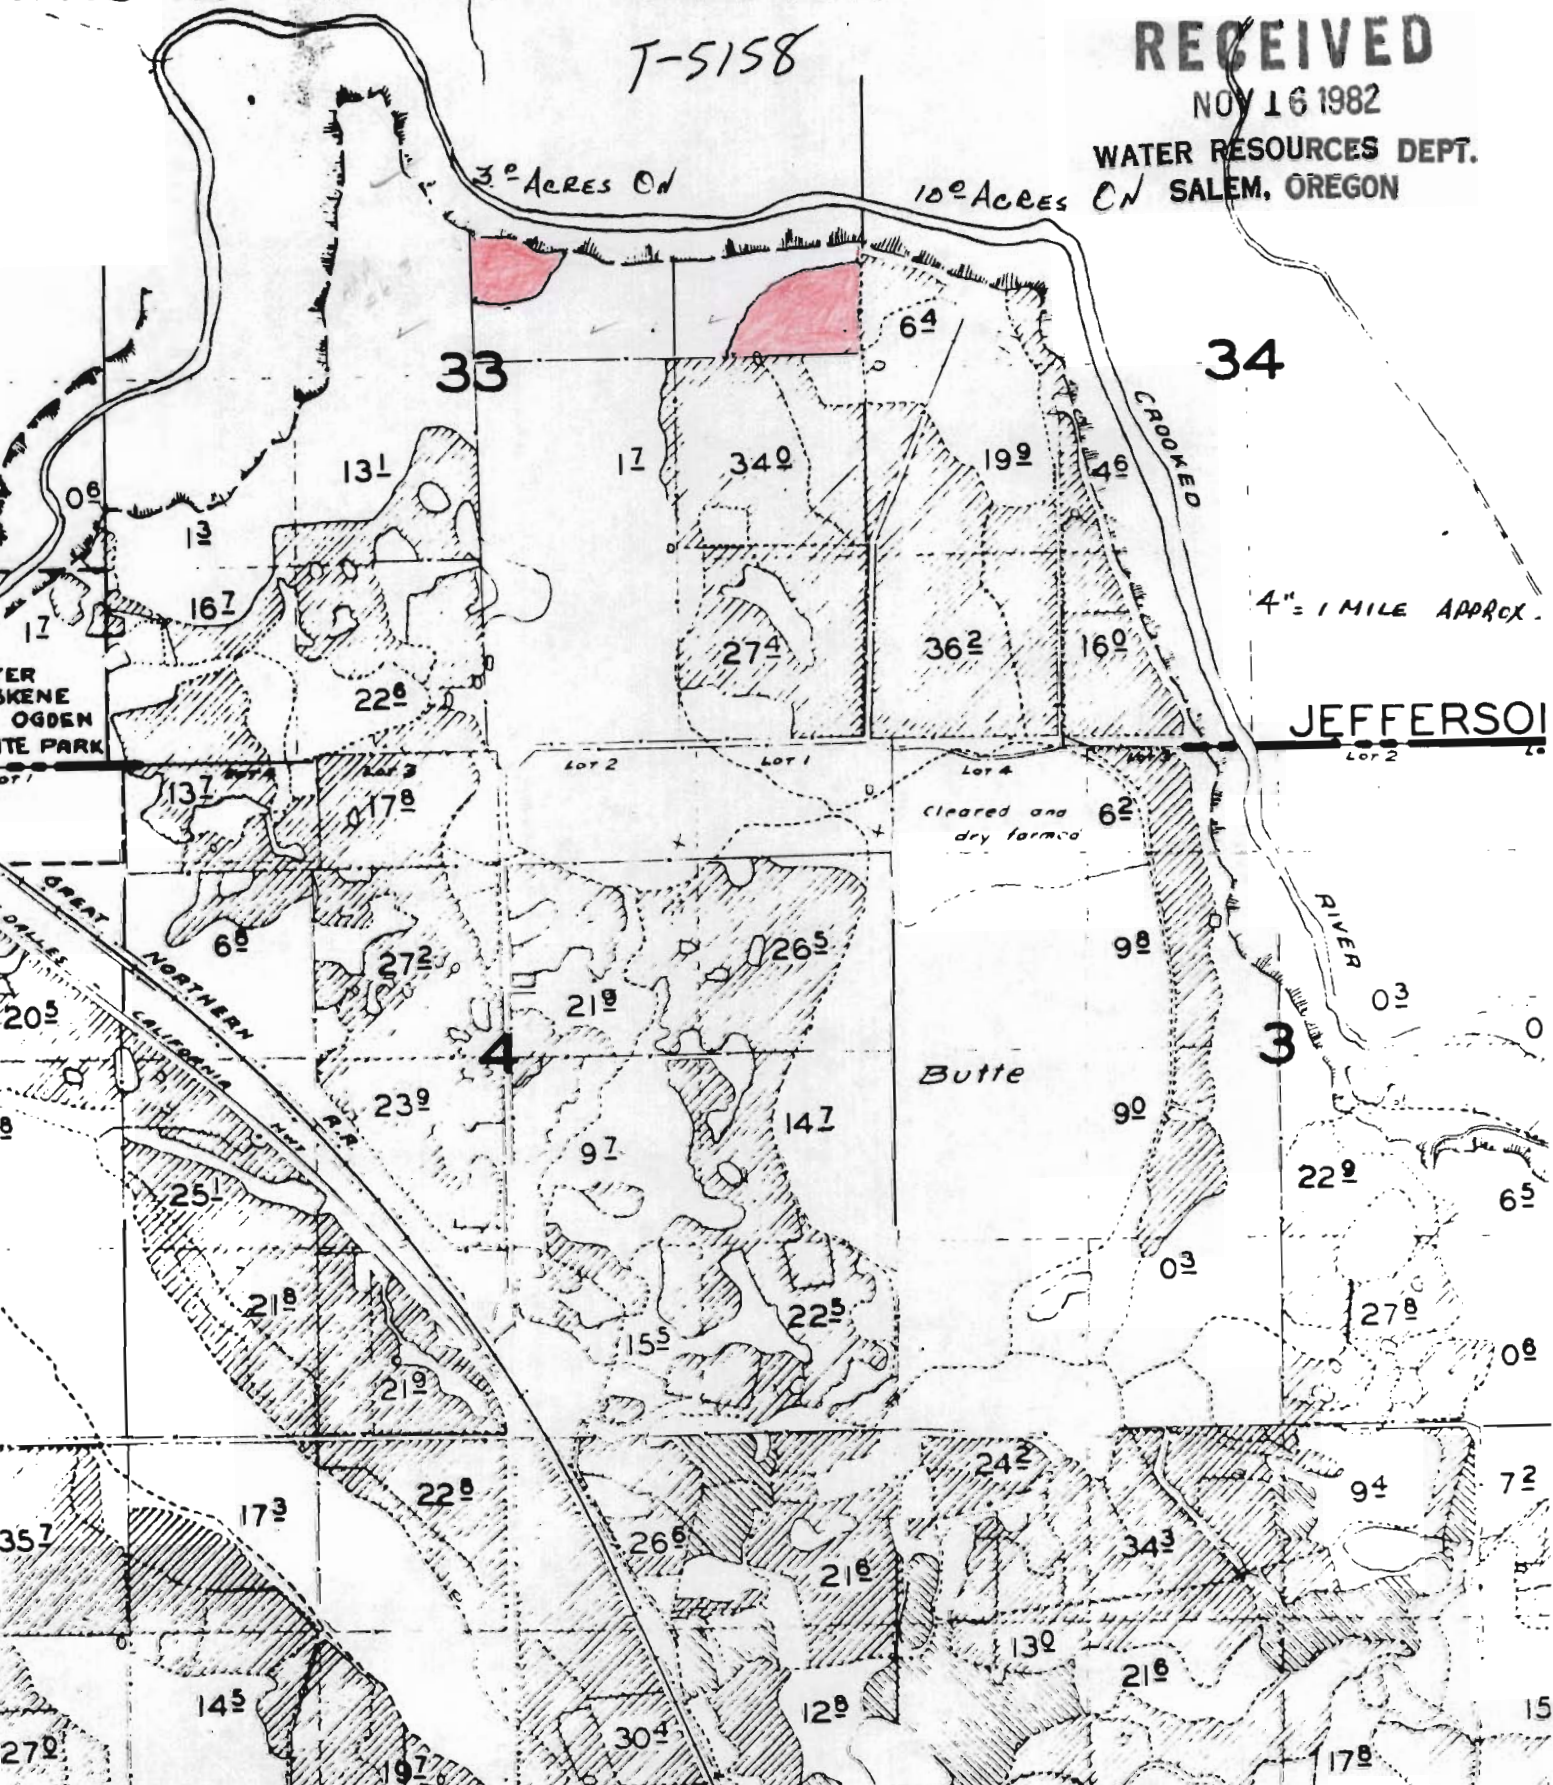


TOWNSHIP 13 AND 14 SOUTH, RANGE 13 E


F-5158

RECEIVED

NOV 16 1982

WATER RESOURCES DEPT.
SALEM, OREGON

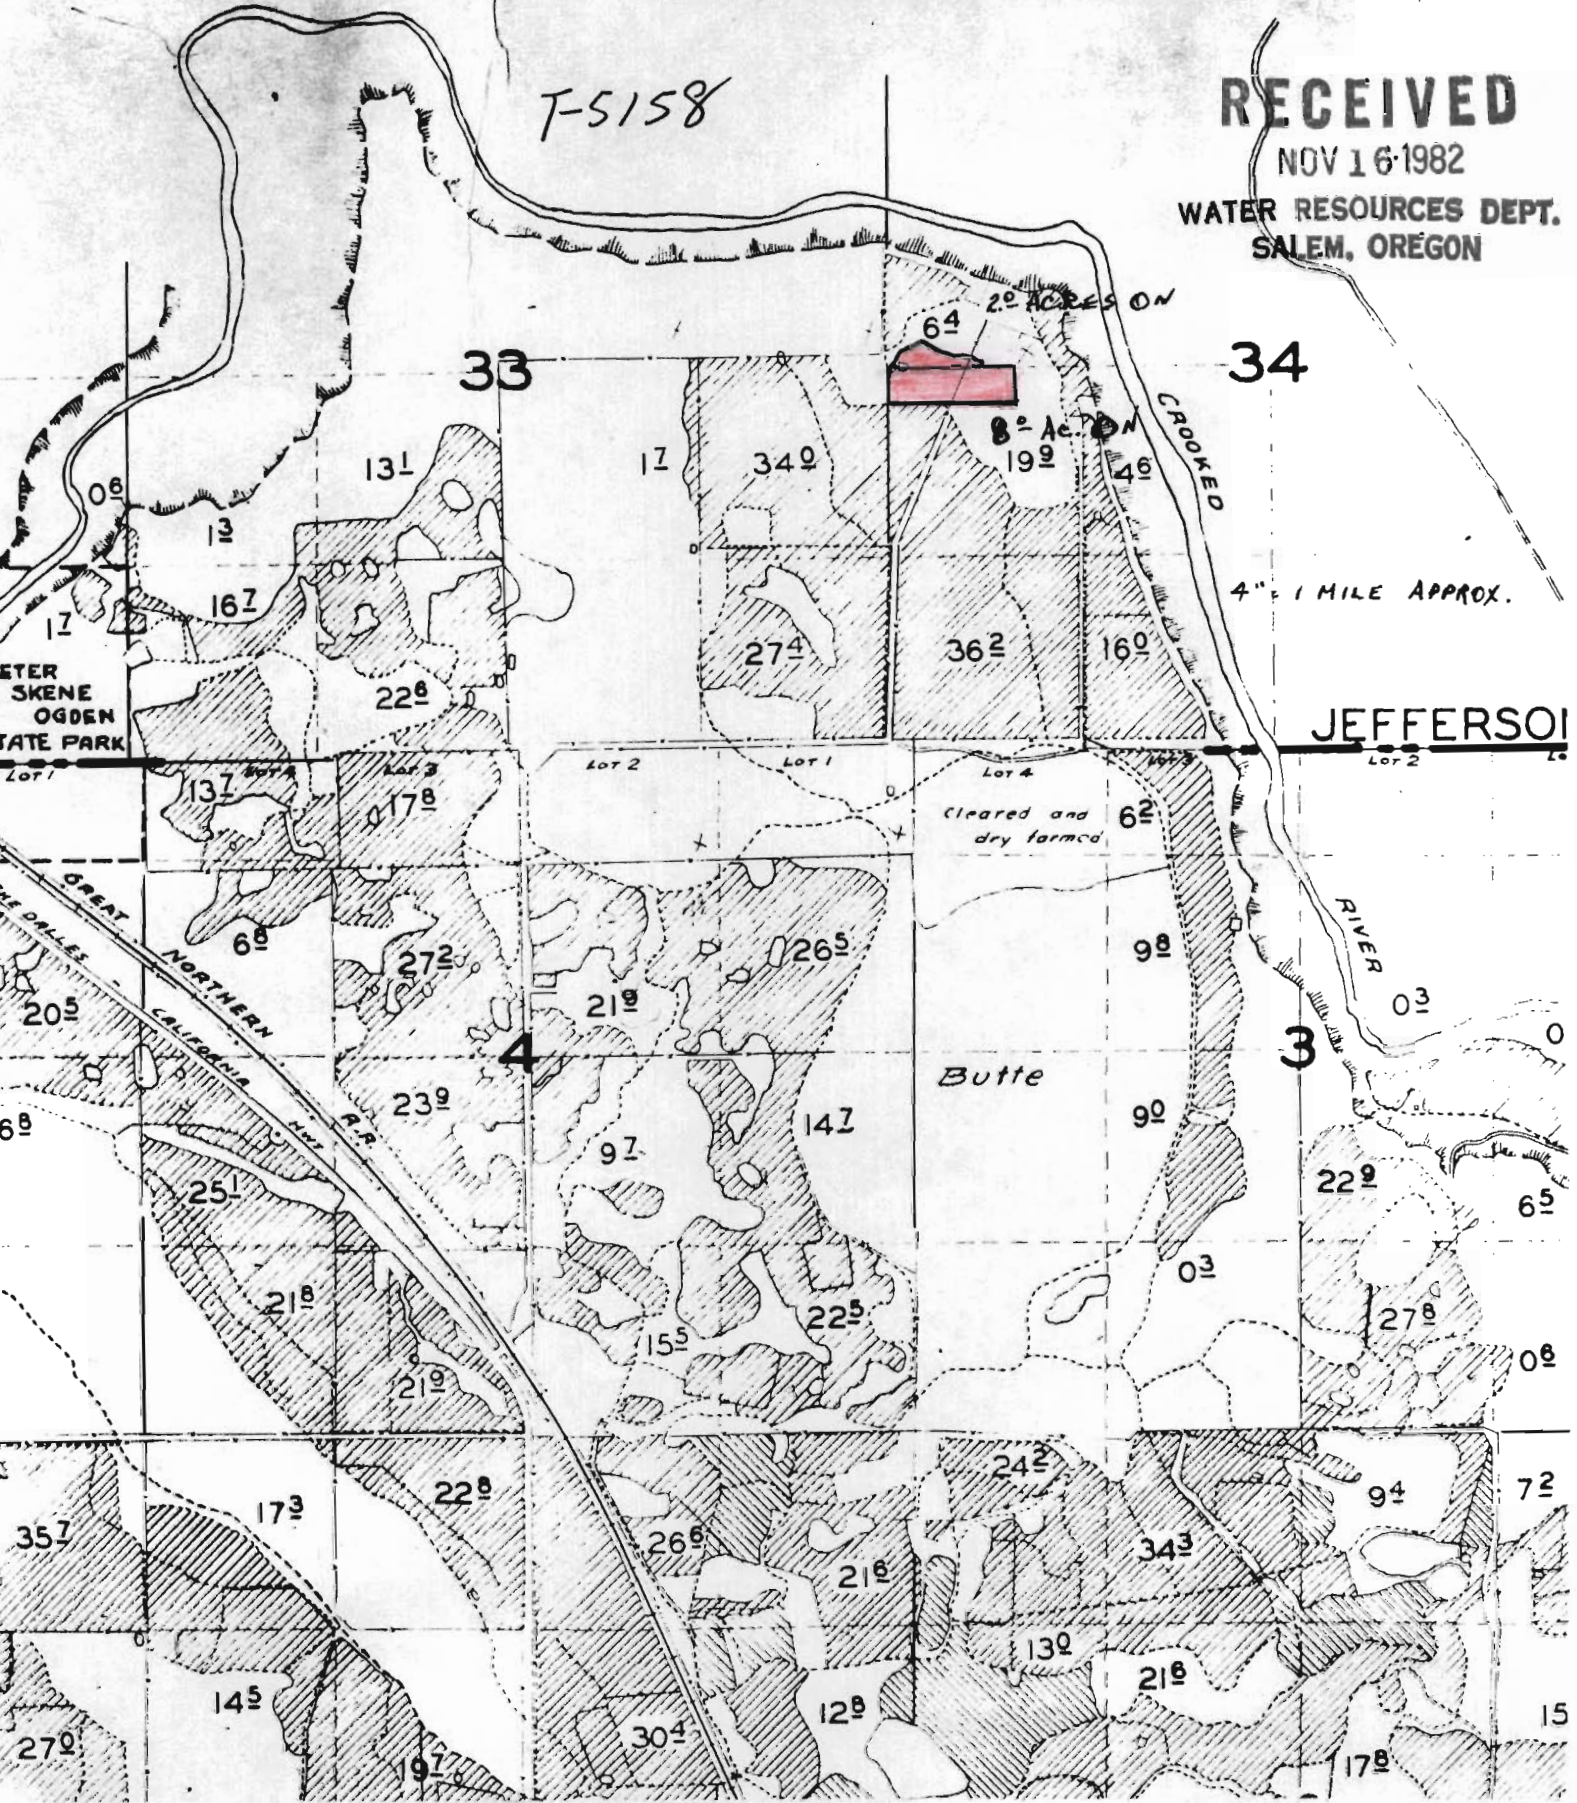

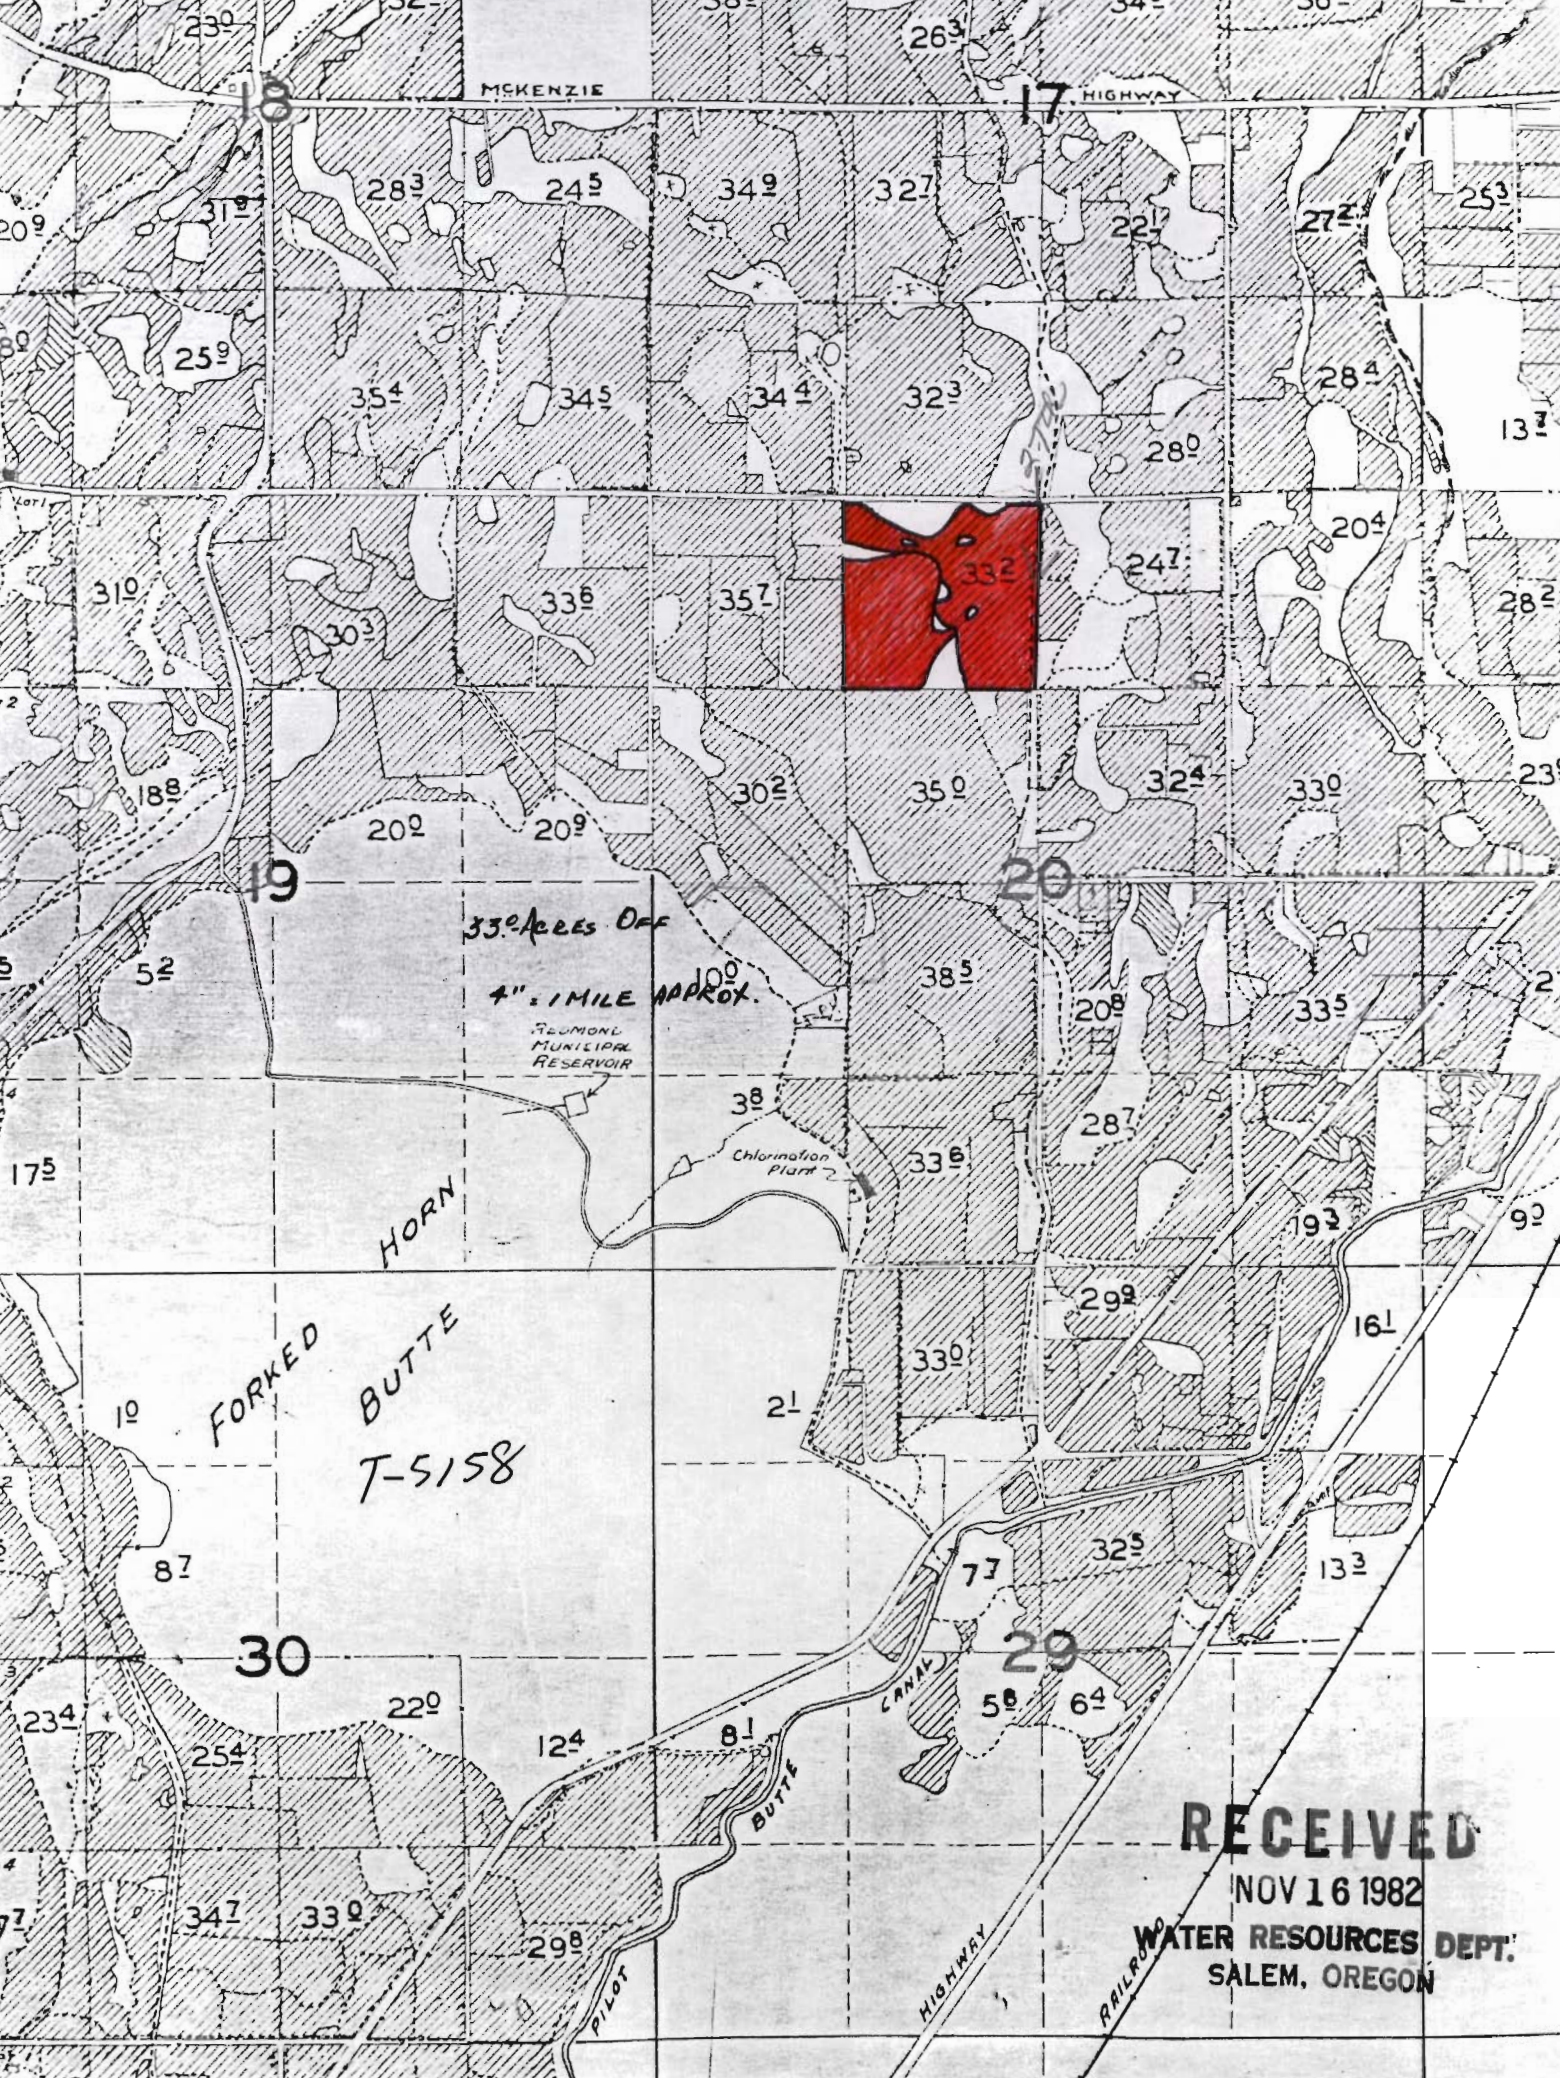

330 ACRES OFF
4" = 1 MILE APPROX.
FEDERAL MUNICIPAL RESERVOIR

FORKED BUTTE
T-5158

RECEIVED
NOV 16 1982
WATER RESOURCES DEPT.
SALEM, OREGON