


# T. 28S., R. 6 W., W.M. SECTION 22

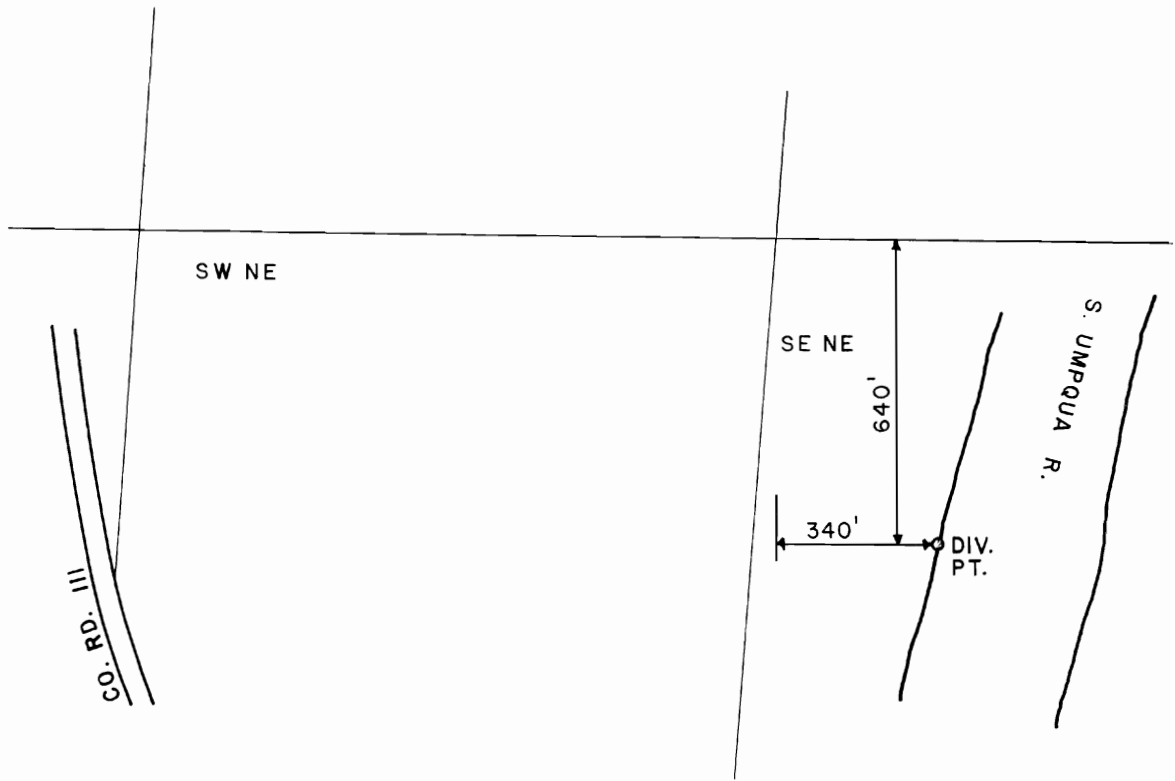

SCALE: 1" = 400'



## FINAL PROOF SURVEY UNDER

TRANSFER NO. T-5162 OLD CERTIFICATE NO. 53310  
IN NAME OF

IVAN O. BUCKLE, et al

Surveyed JUNE 17, 1986, by J. R. KAUPPILA